


T.6S. R.2W. W.M.

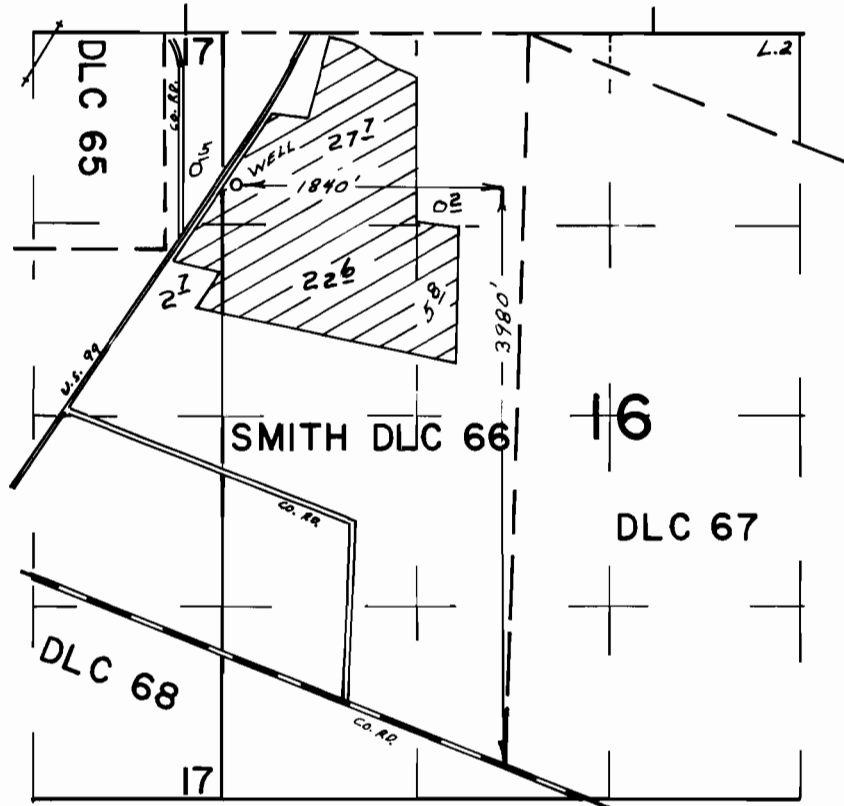

FINAL PROOF SURVEY
UNDER

Application No. G-6879 Permit No. G-6411
IN NAME OF

HATTIE R. GOLLIET

Surveyed APR. 15. 1977. by L.H. NUNN