


T.7S. R.2W. W.M.

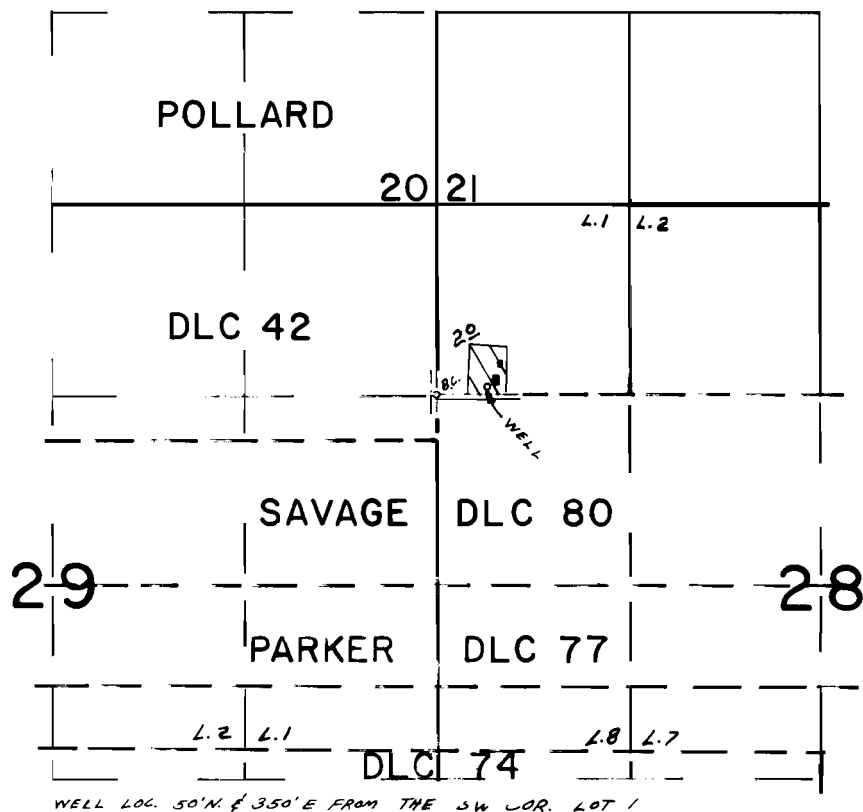

FINAL PROOF SURVEY
UNDER

Application No. G-7056 Permit No. G-6372
IN NAME OF

ALVAH M. HARRISON

Surveyed APR. 13, 1977, by L.H. NUNN