


T.5S.R.IW. W.M.

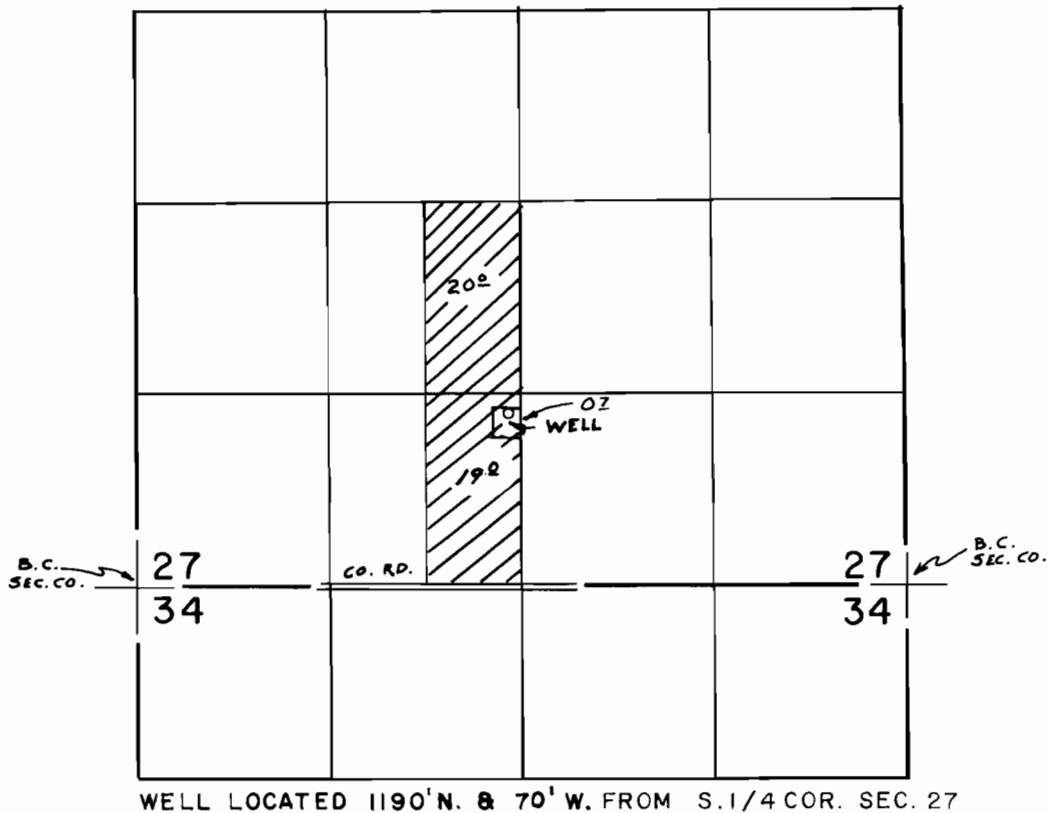

FINAL PROOF SURVEY

UNDER

Application No. G-7114 Permit No. G-6691
IN NAME OF _____

.....ROBERT R. EBNER.....

Surveyed AUG 18 1977, by B.R. SUND