


T.8S.R.4W.W.M.

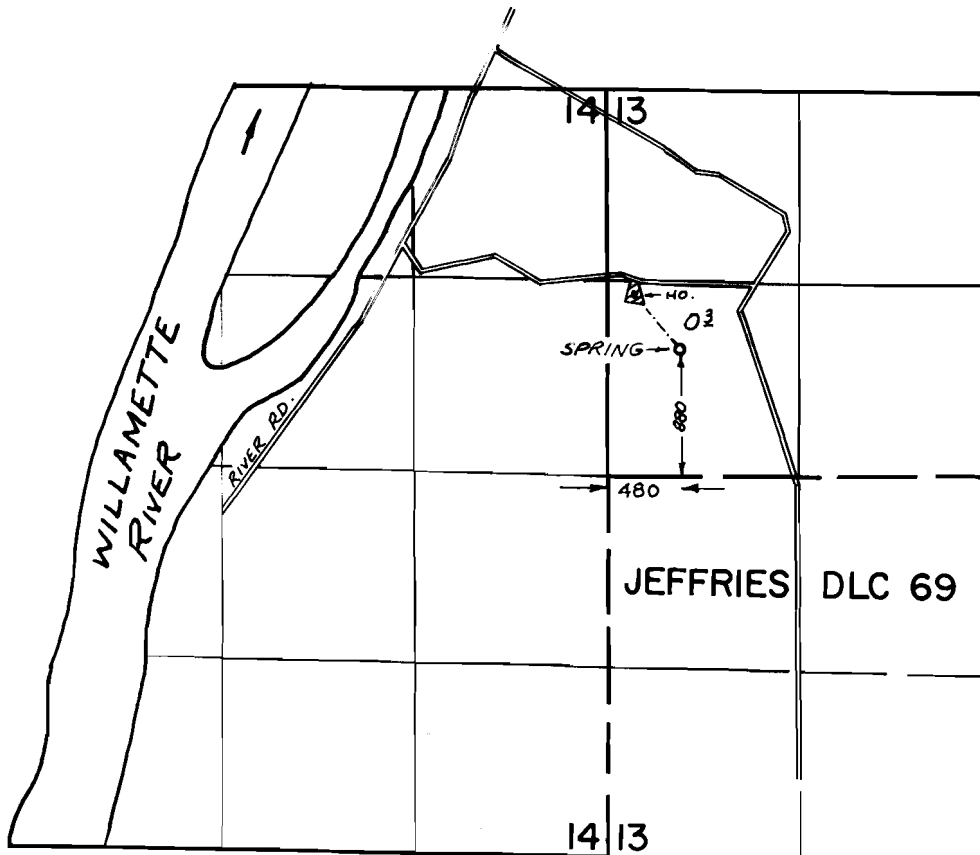

FINAL PROOF SURVEY
UNDER

Application No. 48560 Permit No. 36442
IN NAME OF

Robert Allen & Erma Lee Robertson

Surveyed AUG. 5 1976, by R. MUCKEN