


T. 3S. R. 1W., W.M.

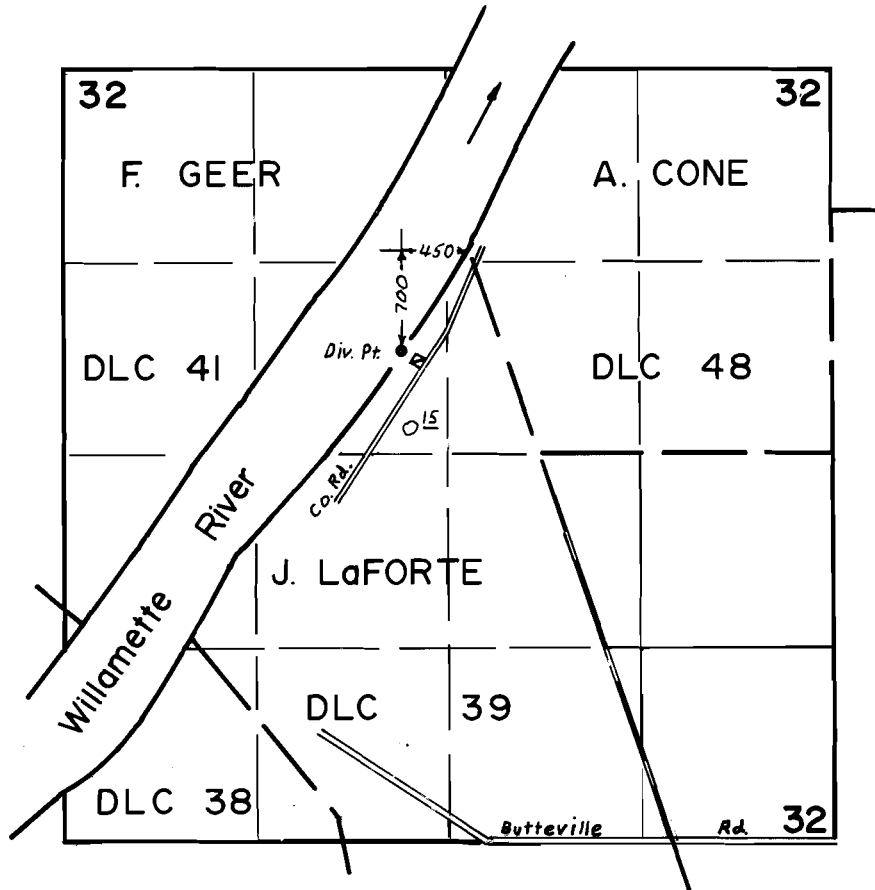

FINAL PROOF SURVEY UNDER

Application No. 53181..... Permit No. 39465.....
IN NAME OF

.....SOLOMON W. MESERVE.....

Surveyed SEPT. 7. 1977, by B. R. SUND.....