


# T.6S.,R.1E.,W.M.

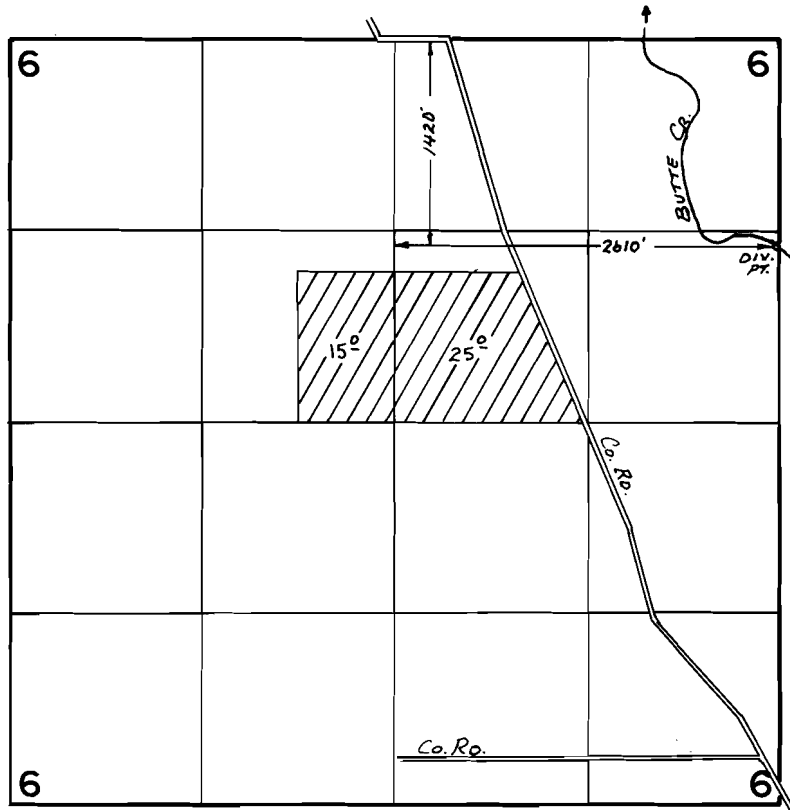

## FINAL PROOF SURVEY UNDER

Application No. 53406 Permit No. 39746  
IN NAME OF

AAA FARMS

Surveyed Aug. 11, 1976, by L. T. G. L.