


T.5S. R.1W. W.M.

SCALE: 1"=660'

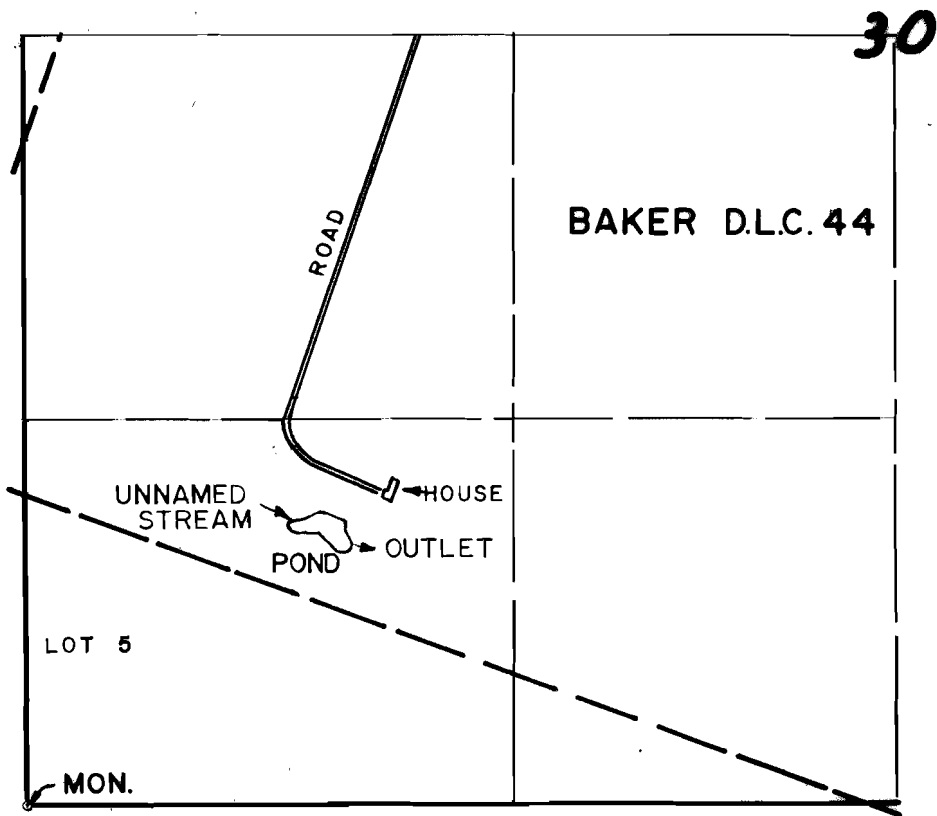

FINAL PROOF SURVEY UNDER

Application No. R.53668... Permit No. R.6430....
IN NAME OF

.....ARTHUR J. METZ.....

Surveyed AUG. 18... 1977, by BRUCE R. SUND....