


T.6S.,R.4W.,W.M.

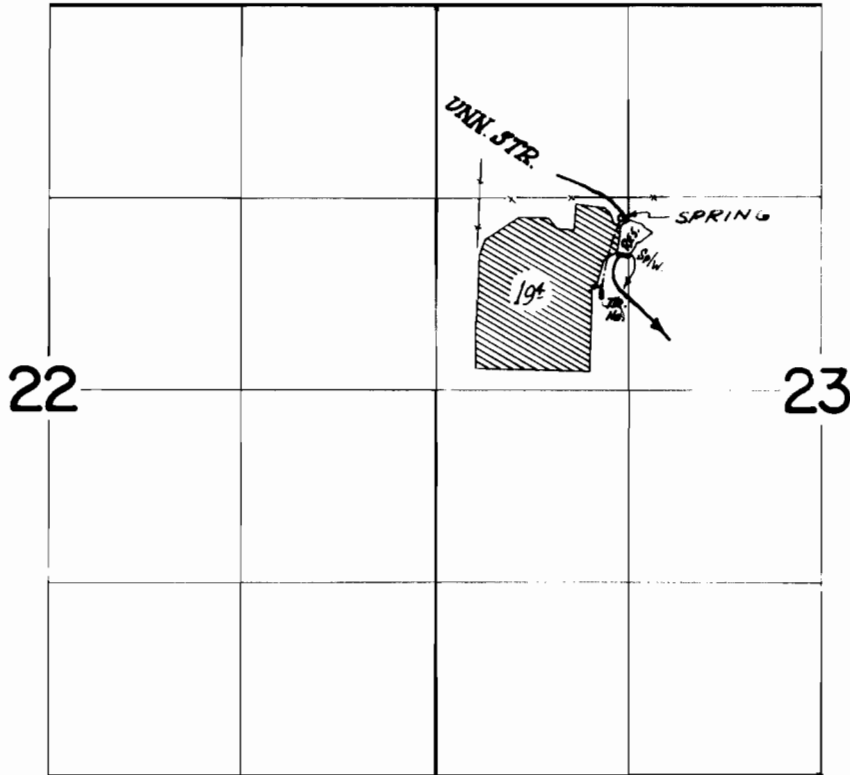

Div. Pts. located: Domestic- 1180' N. & 1260' E.; Res- 930' N. & 1240' E., both from NW 1/4 cor. Sec. 23.

FINAL PROOF SURVEY
UNDER

R-47367 R-5880
Application No. **47368** Permit No. **36338**
IN NAME OF

VICTOR H. & NANCY WINQUIST

Surveyed *Aug. 11* 1977, by *L.M. Toll*