


T.6S.,R.4W.,W.M.

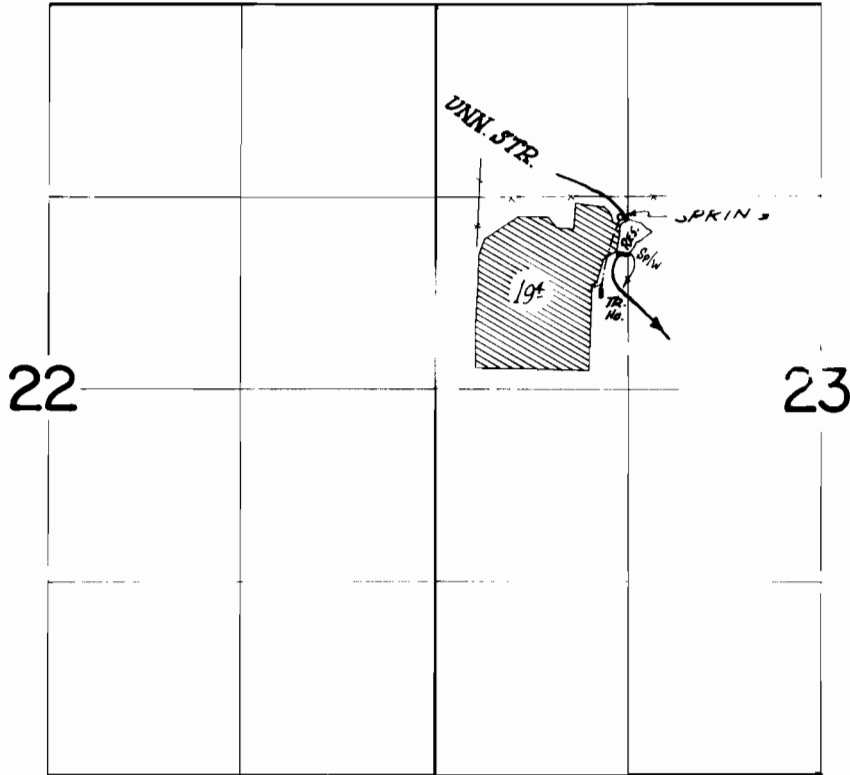

Div. Pts. located: Domestic- 1180' N. & 1260' E.; Res- 930' N. & 1240' E., both from W 1/4 cor. Sec. 23.

FINAL PROOF SURVEY
UNDER

R-47367 R-5880
Application No. 47368 Permit No. 36338
IN NAME OF

VICTOR H. & NANCY WINQUIST

Surveyed Aug. 11 1977, by L.M. Toll