T. 8S. R.6W., W.M.

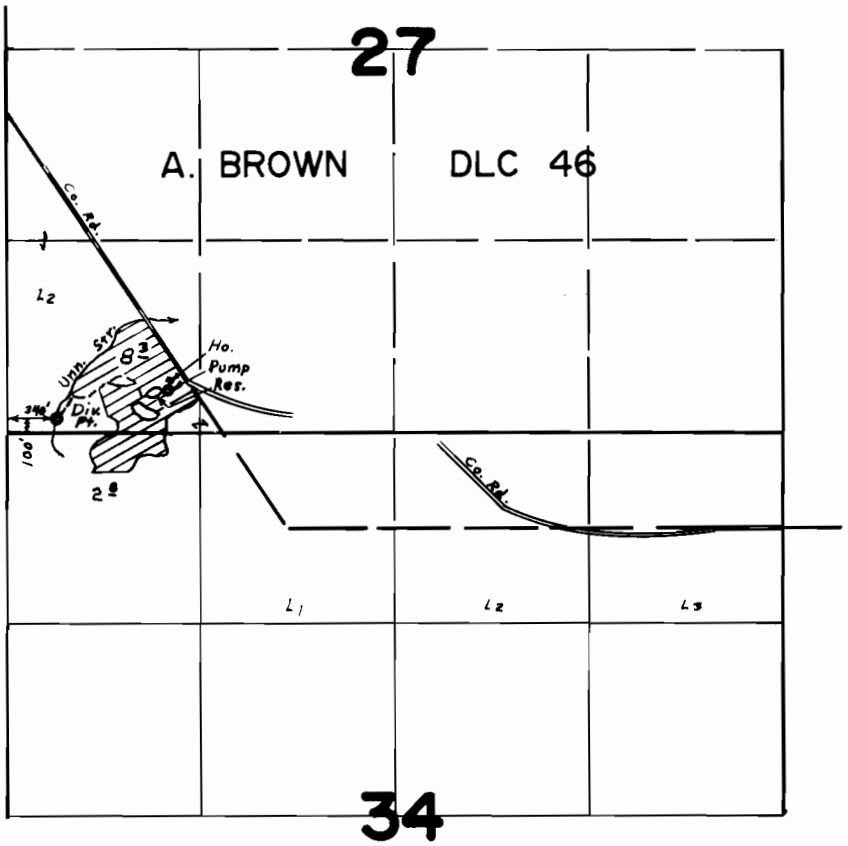

FINAL PROOF SURVEY
UNDER

Application No. 49737 Permit No. 37246
IN NAME OF

JAMES H. LIND & SHARIE Y. RODY

Surveyed MAR 15 1978, by J. S. DONALDSON

DEP-HLL-43