


T.6S. R.7W., W.M.

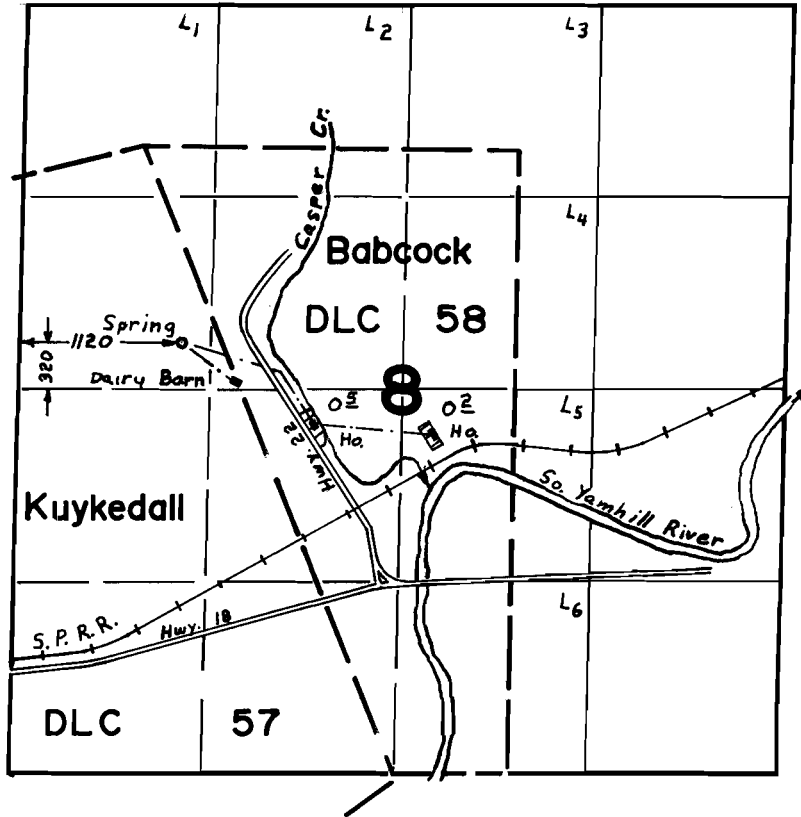

FINAL PROOF SURVEY UNDER

Application No. 53062... Permit No. 40315.....
IN NAME OF

ELMER, DENNIS, & JIM WERTH.....

Surveyed SEP. 16. 1977, by D.M. NORBY.....