


T.2N. R.10W. W.M.

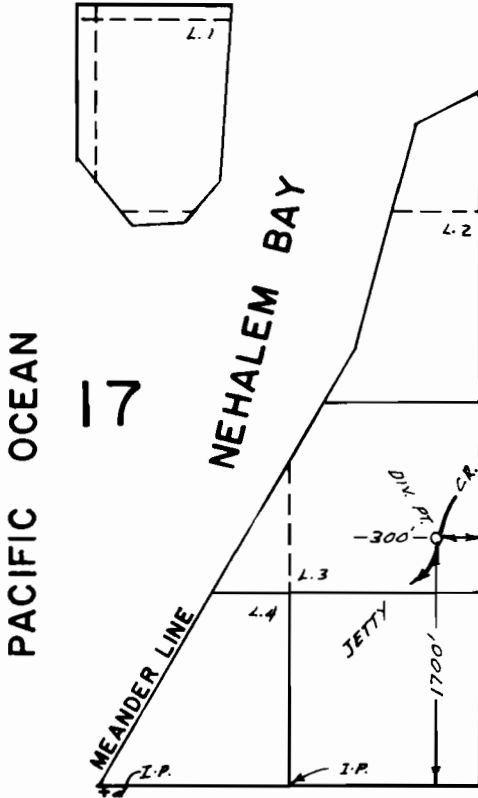

FINAL PROOF SURVEY
UNDER

Application No. 46578.... Permit No. 3.4498....
IN NAME OF

.....CITY OF ROCKAWAY.....

Surveyed JUL...28. 1977., by L.H. NUNN.....