


T.2S. R.10W. W.M.

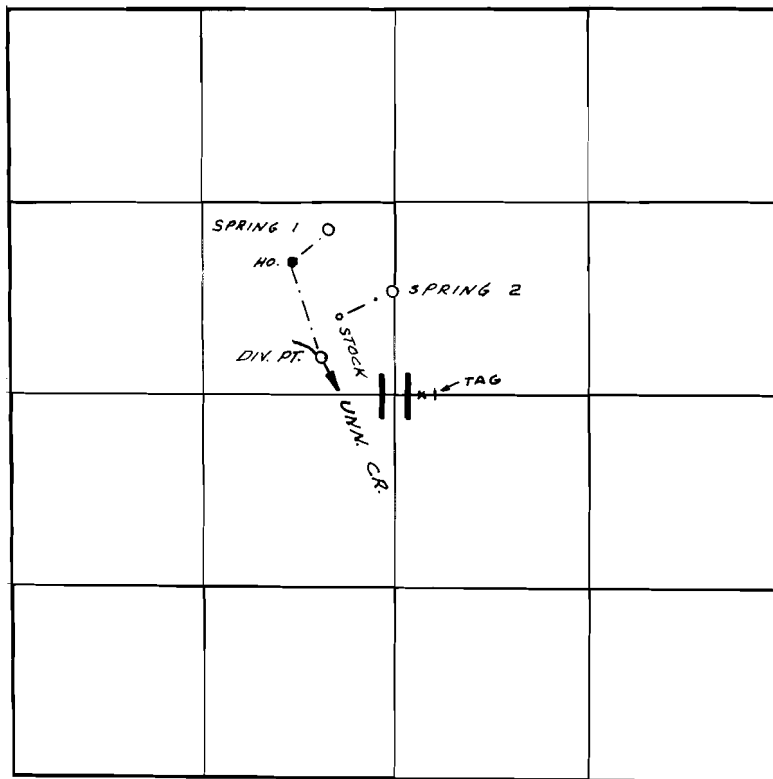

SPRING 1 - 1130' N. & 460' W. ; SPRING 2 - 600' N. & 20' W. ;
DIV. PT. - 250' N. & 500' W. ; ALL FROM THE CENTER SEC. 11

FINAL PROOF SURVEY
UNDER

Application No. 48143..... Permit No. 36176.....
IN NAME OF

..... DOUGLAS H. MACHEN

Surveyed AUG. 3..... 1977., by L.H. NUNN.....