


T.1S. R.9W. W.M.

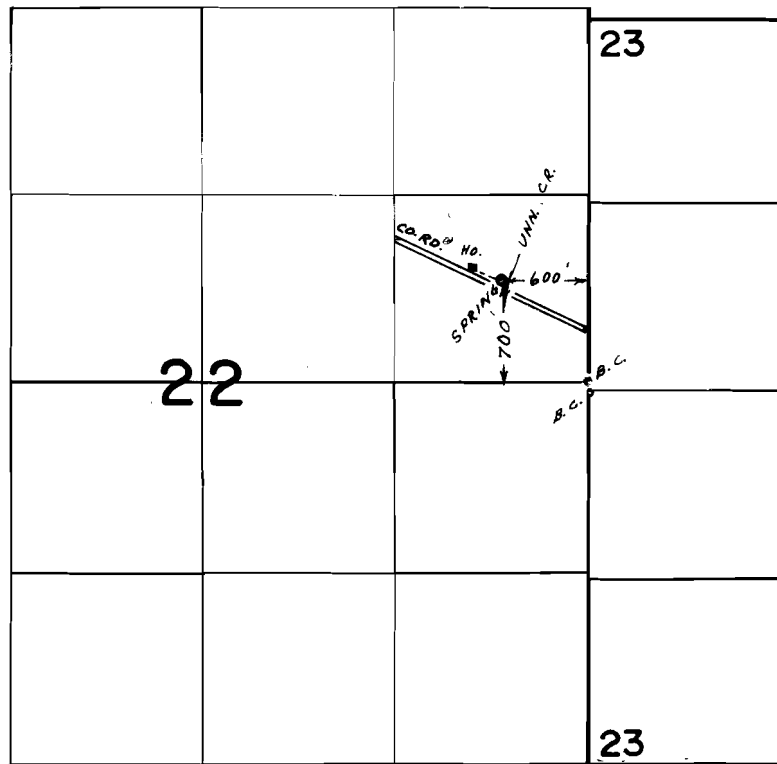

FINAL PROOF SURVEY
UNDER

Application No. 53316 Permit No. 39559
IN NAME OF

LLOYD J. BAERTLEIN

Surveyed JUL. 29. 1977, by L.H. NUNN