


G-5283
47958

SHENANDOAH ESTATES

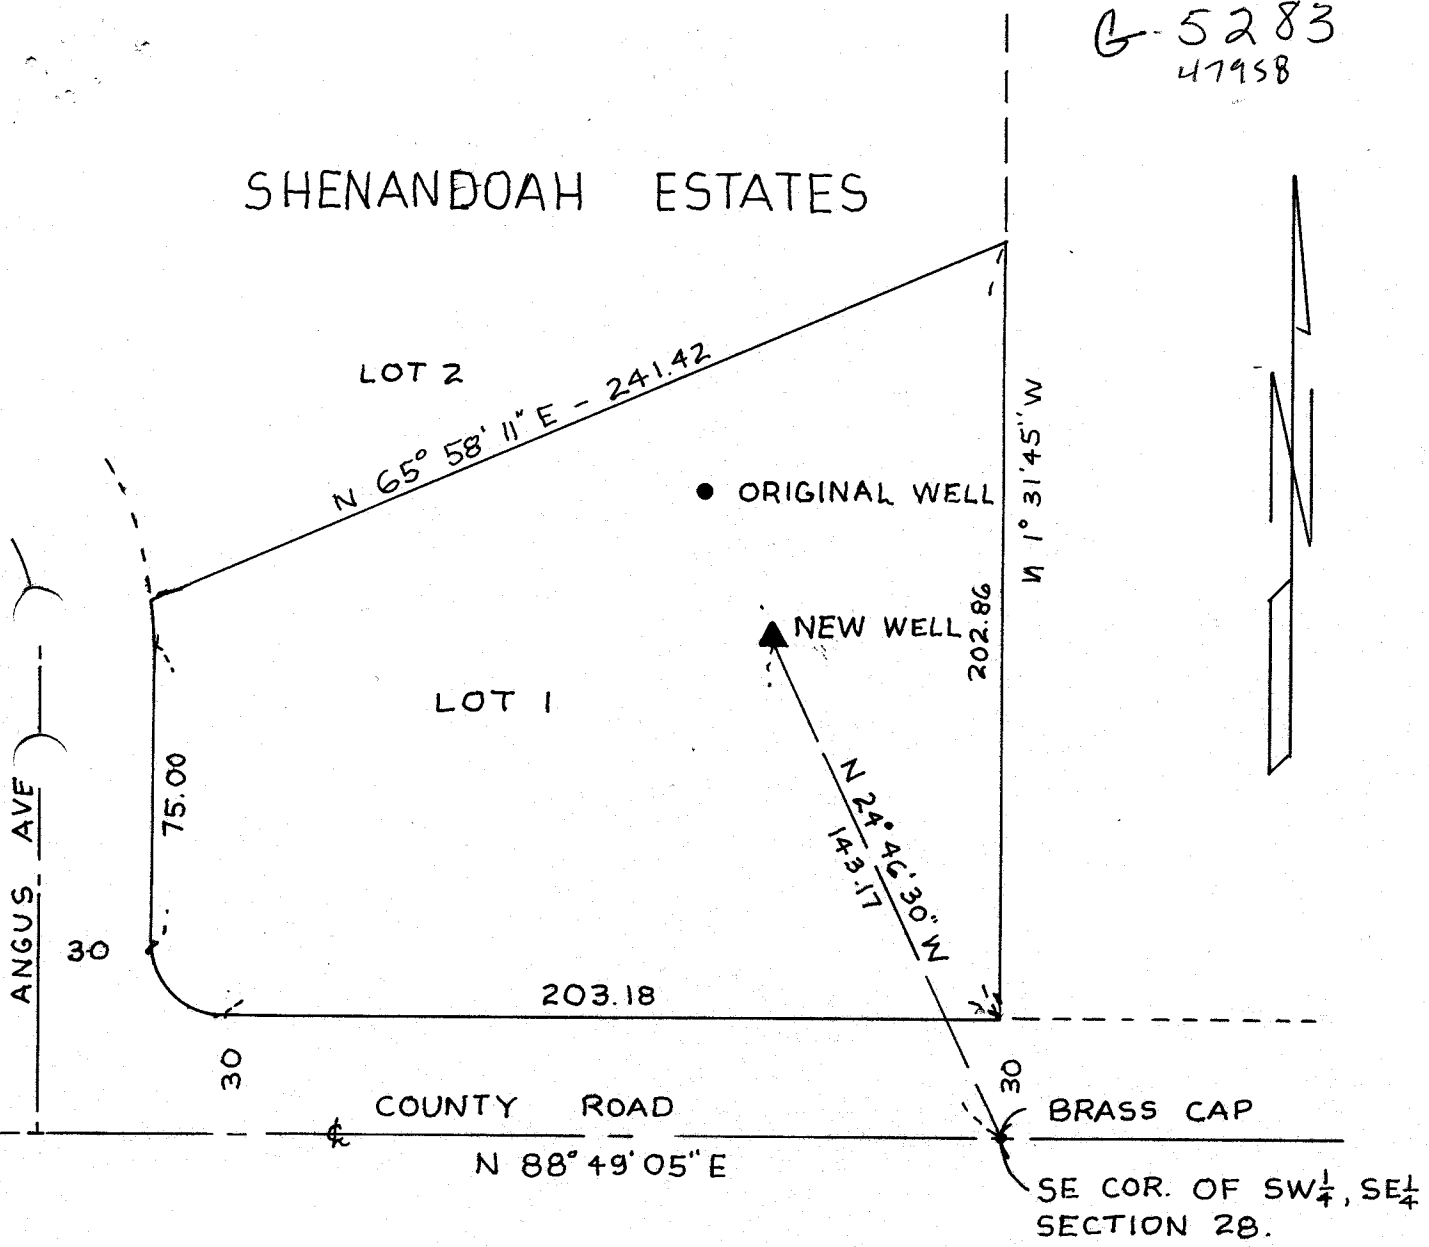

| | | | | |
|---|-------------------|----------------|--------------------|------------|
| KRUMBEIN ENGINEERING LTD. ENGINEERS - SURVEYORS - PLANNERS 361 S.E. Second Pendleton, Oregon | Scale 1" = 50' | Drn. By DHK | Drng. No. 9213A | Revision 1 |
| | Date 11-29-92 | Ckd. By | Job No. 8917 | Revision 2 |

FINAL PROOF MAP
HERITAGE
IMPROVEMENT
DISTRICT
SEC. 28, T. 2 N., R. 33 E. W. M.

