


T.6N. R.35E. WM.

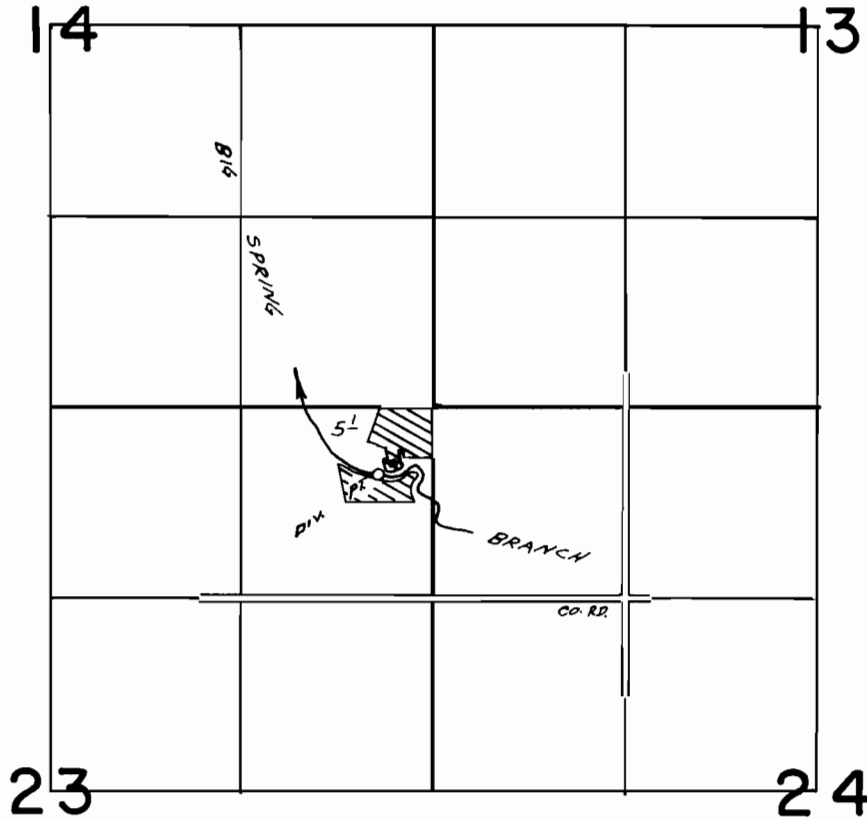

DIV. PT. LOC. 440'S. & 370'W. FROM NE COR. SEC. 23

FINAL PROOF SURVEY
UNDER

Application No. 48422... Permit No. 36349...
IN NAME OF

.....WALTER DAVIS.....

Surveyed APR. 28 1977., by L.H. NUNN.....