


T.2N. R.33E. W.M.

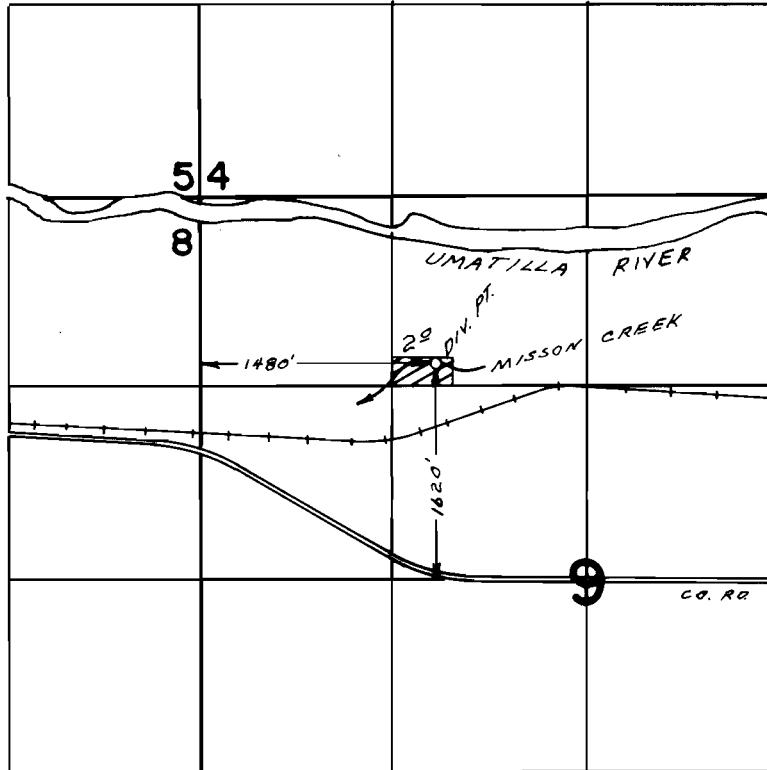

FINAL PROOF SURVEY
UNDER

Application No. 49353..... Permit No. 36997.....
IN NAME OF

.....**WILLIAM CLARK**.....

Surveyed MAY 3..... 1977., by L.H. NUNN.....