




# T.4S. R.13E., W.M.

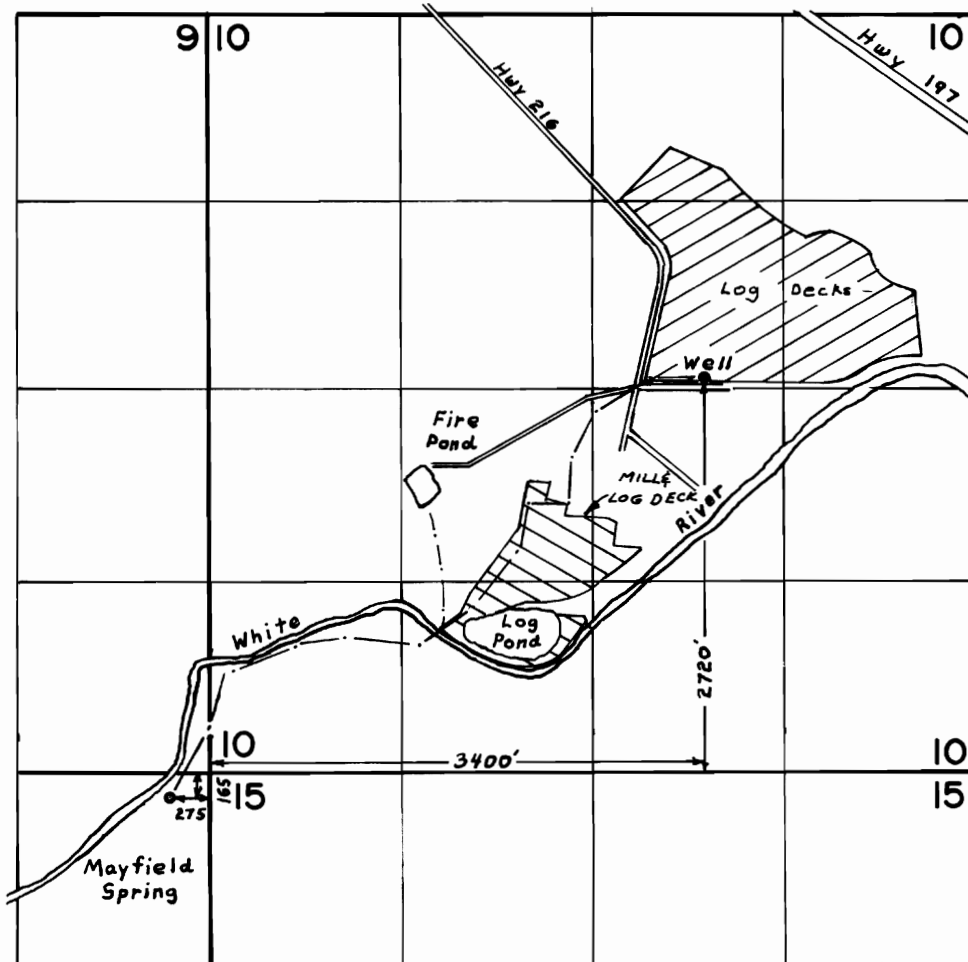

 App'l. 54579 & G-7453  
 App'l. 49623 & Tr. 2691

## FINAL PROOF SURVEY UNDER

Transfer No. 2691  
 G-7453                      G-6945  
 49623                      36160  
 Application No. 54579... Permit No. 40955...  
 IN NAME OF

...MOUNTAIN FIR LUMBER CO., INC.

Surveyed SEP. 14. 1977., by L.H. NUNN.....