


T.2N. R.13E. W.M.

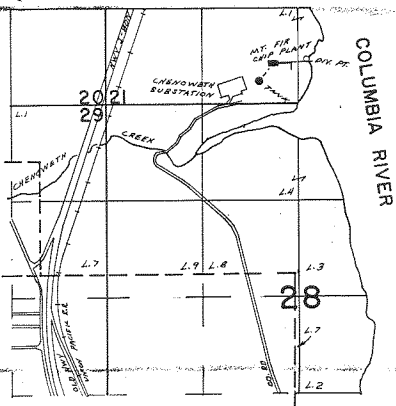

FINAL PROOF SURVEY UNDER

Application No. 54562... Permit No. 40941....
 IN NAME OF
MT. FIR LUMBER CO., INC.....
 Surveyed SEP. 13... 1977., by L.H. NUNN.....