


T.2N. R.3W. W.M.

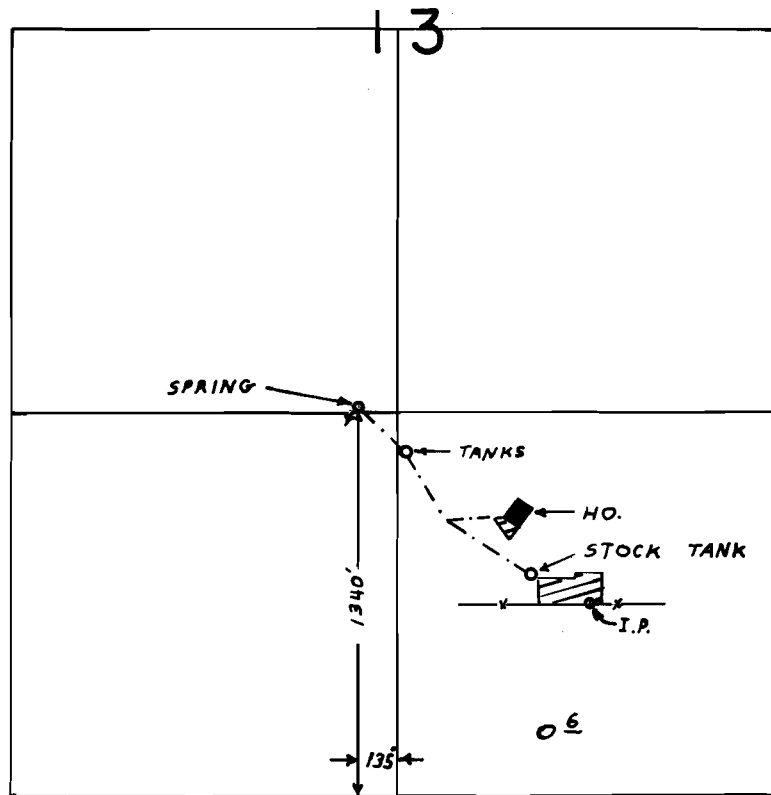

SCALE: 1"=660'

**FINAL PROOF SURVEY**  
UNDER

Application No. 50035..... Permit No. 36525.....  
IN NAME OF

.....**ROBERT WELLER**.....

Surveyed NOV...9... 1977, by R.G. MUCKEN.....