


T.5S. R.3W. W.M.

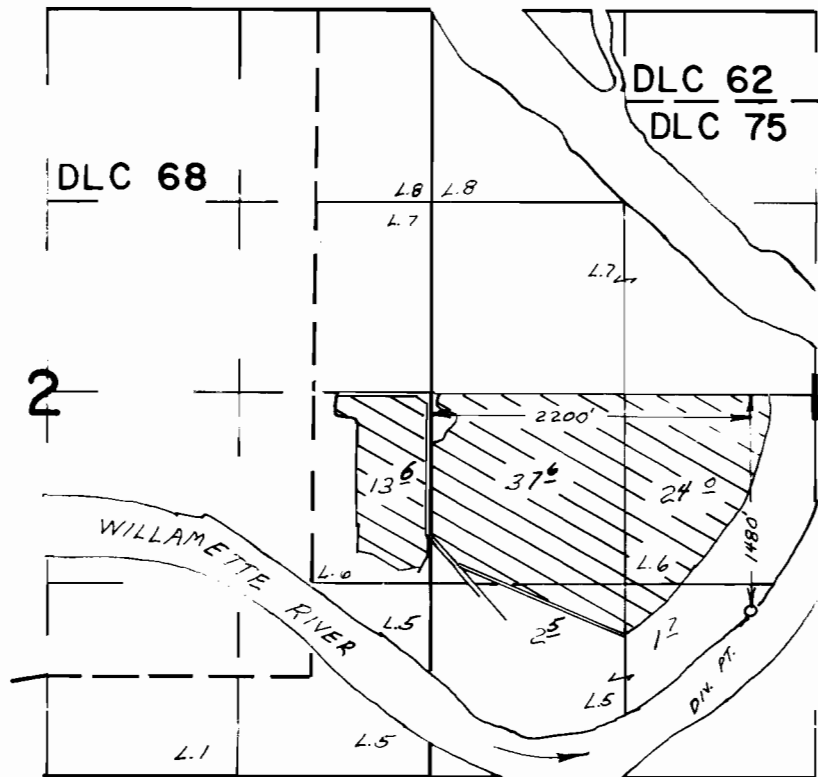

FINAL PROOF SURVEY
UNDER

Application No. 49091 Permit No. 36826
IN NAME OF

GUY FRESHOUR

Surveyed AUG. 9 1977, by L.H. NUNN