T.5S. R.6W. W.M.

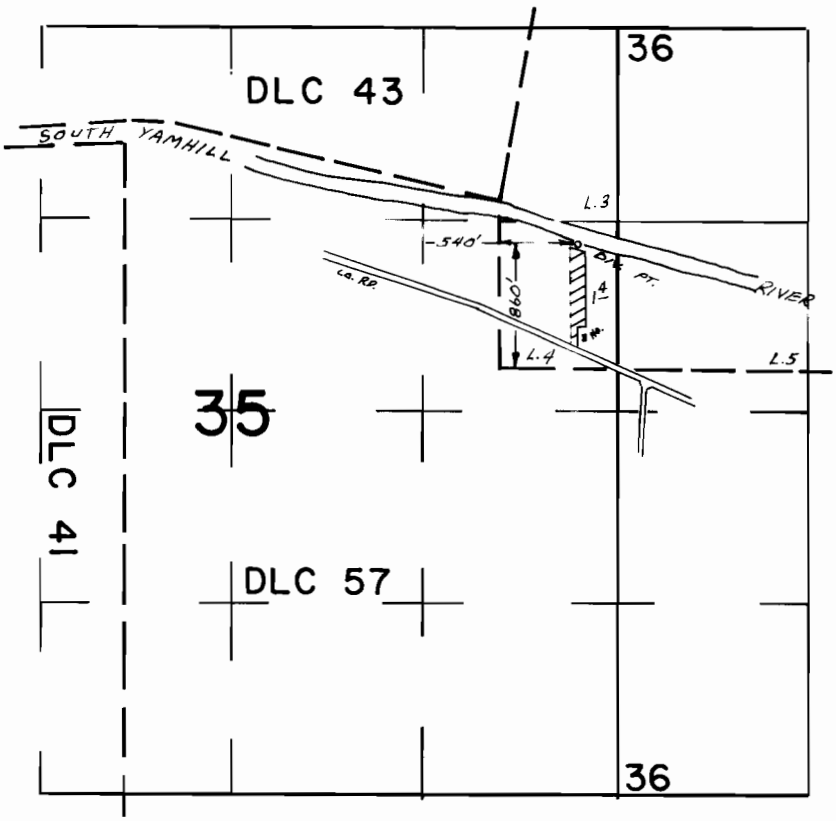

FINAL PROOF SURVEY
UNDER

Application No. 51932 Permit No. 39070
IN NAME OF

ALFRED TURNER

Surveyed SEP. 6 1977, by L.H. NUNN

DFQ 3LL-149