


T. 5S., R. 4 W., W.M.

SECTION 27

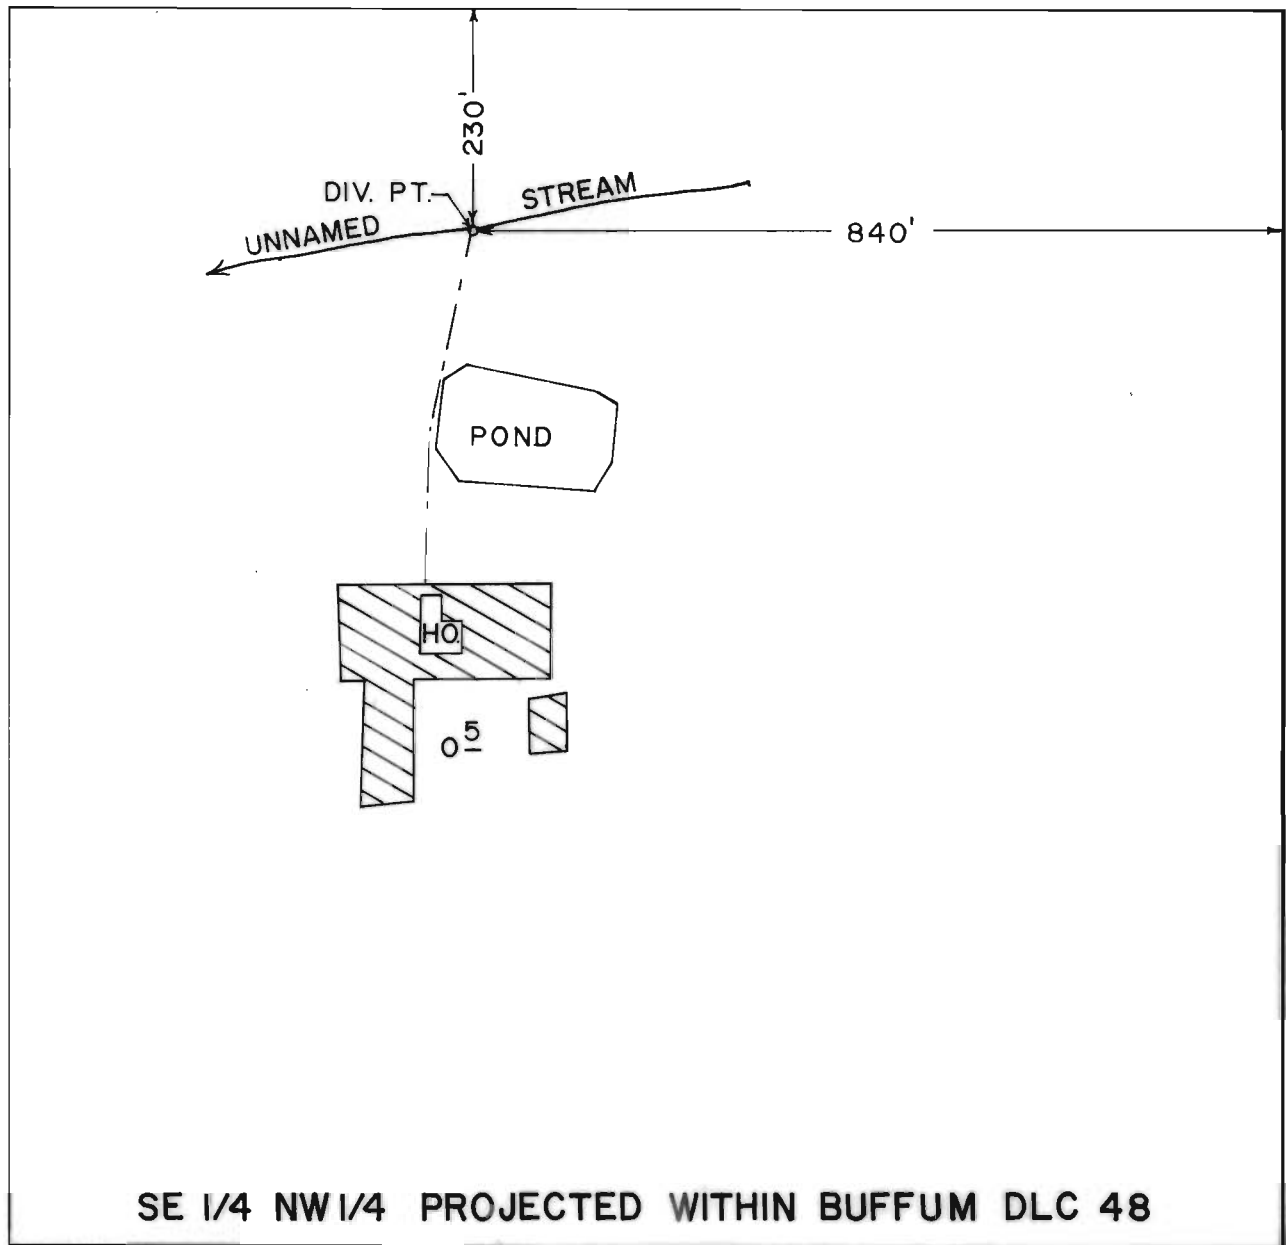

SCALE 1" = 200'

**FINAL PROOF SURVEY**  
UNDER

Application No. 52750... Permit No. 39837...  
IN NAME OF

.....**MERLE WILLIAMS**.....

Surveyed AUG. 10... 1977., by L.H. NUNN.....