


T.4S. R.7W. W.M.

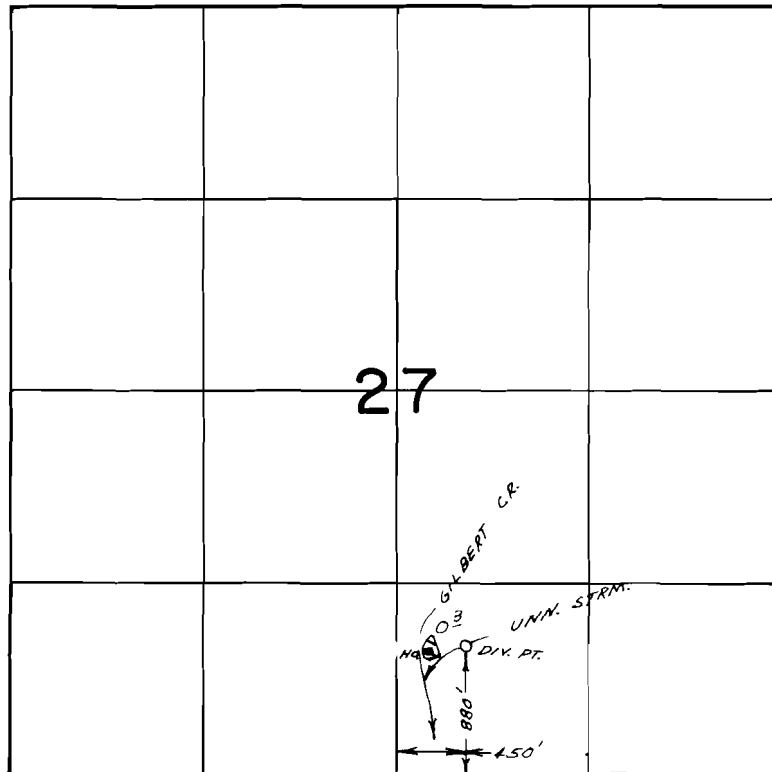

FINAL PROOF SURVEY
UNDER

Application No. 53502..... Permit No. 40319.....
IN NAME OF

GARY D. & MARY CAROLE LAWRENCE

Surveyed SEP. 8, 1977, by L.H. NUNN.....