


T.5S. R.6W. W.M.

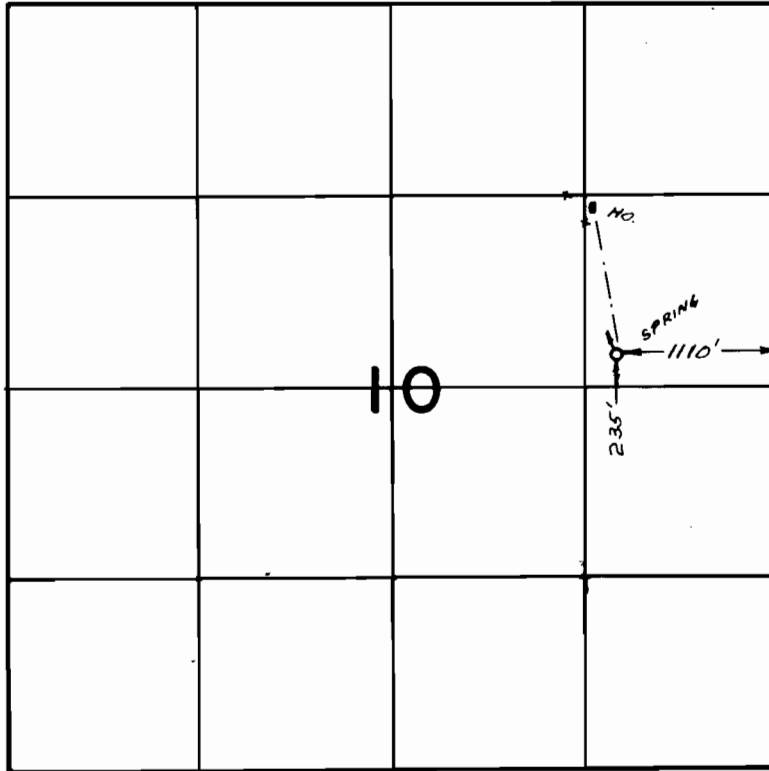

FINAL PROOF SURVEY
UNDER

Application No. 53863..... Permit No. 40195.....
IN NAME OF

.....ERNEST O. BARNES.....

Surveyed SER. 7..... 1977., by L.H. NUNN.....