


T.3S. R.5W. W.M.

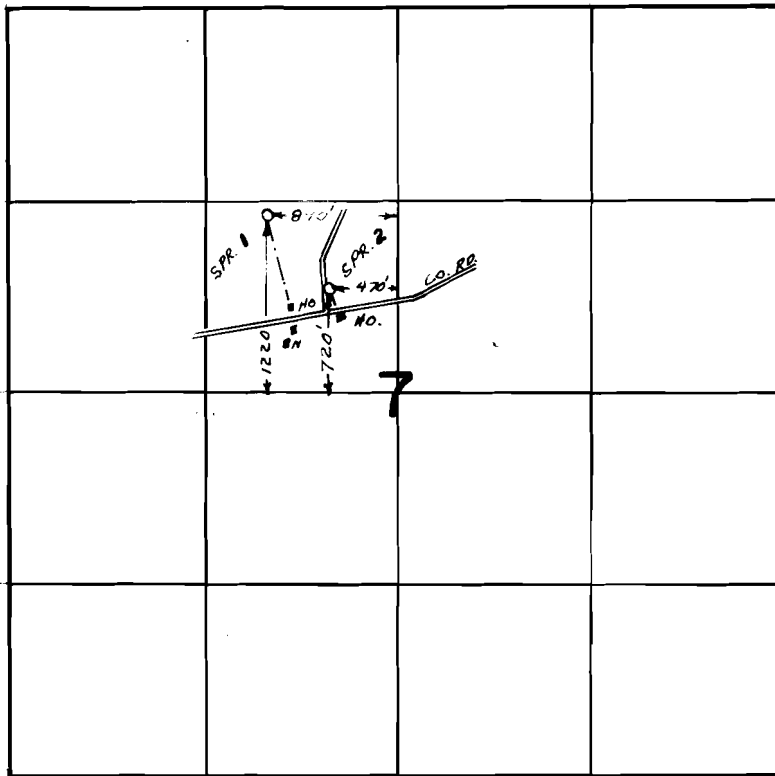

FINAL PROOF SURVEY
UNDER

Application No. 53997..... Permit No. 40409....
IN NAME OF

.....GEORGE & ZOLA YATES.....

Surveyed OCT. 6... 1977., by L.H. NUNN.....