


T.3S. R.30E. W.M.

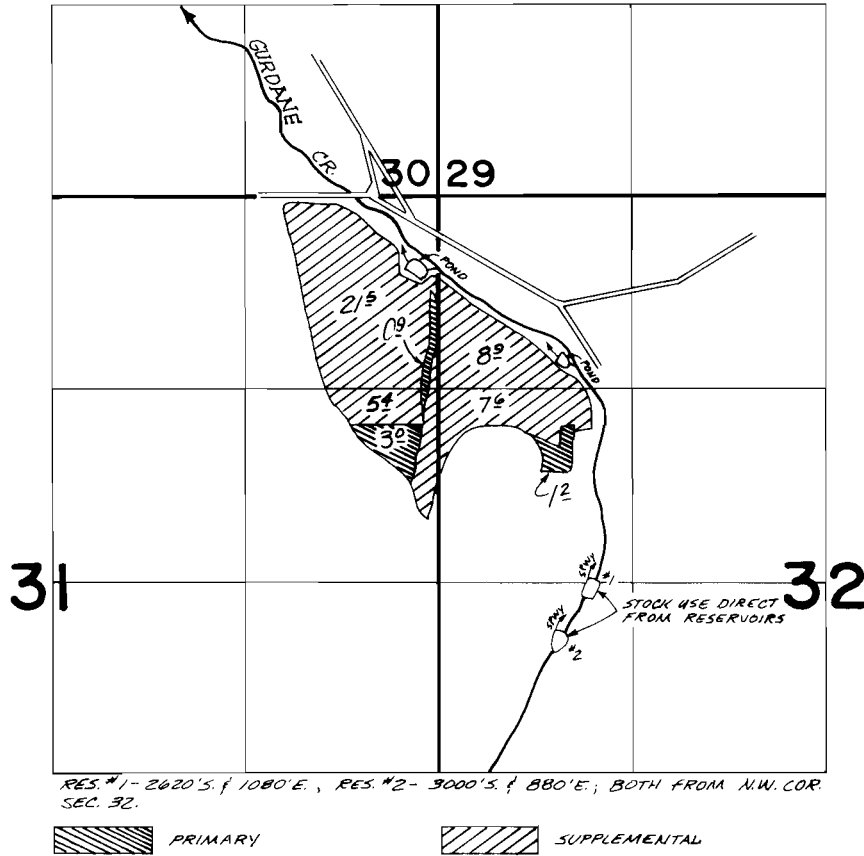

FINAL PROOF SURVEY UNDER

R 45328 R5352
 Application No. 45257 Permit No. 33802
 IN NAME OF

Con Doherty

Surveyed OCT. 22 19.75, by D.NORBY