


T.13S.,R.6W.,W.M.

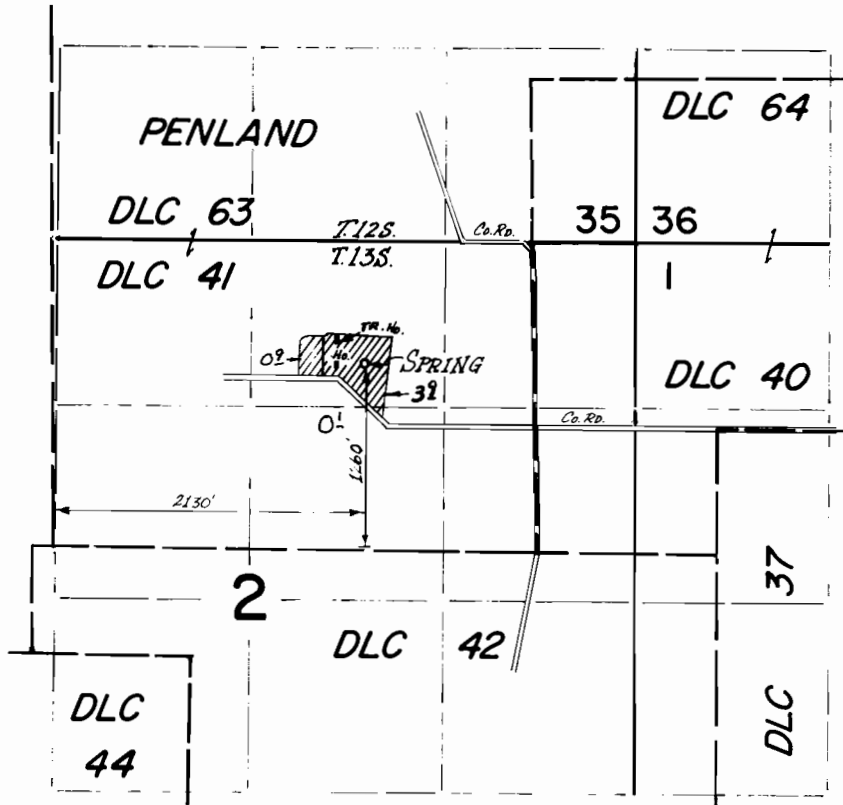

FINAL PROOF SURVEY UNDER

Application No. 54345 Permit No. 40739
IN NAME OF

EJNER J. FULSANG, Jr.

Surveyed JUNE 3 1977, by L. M. TOLL