T2S. R2E. WM.

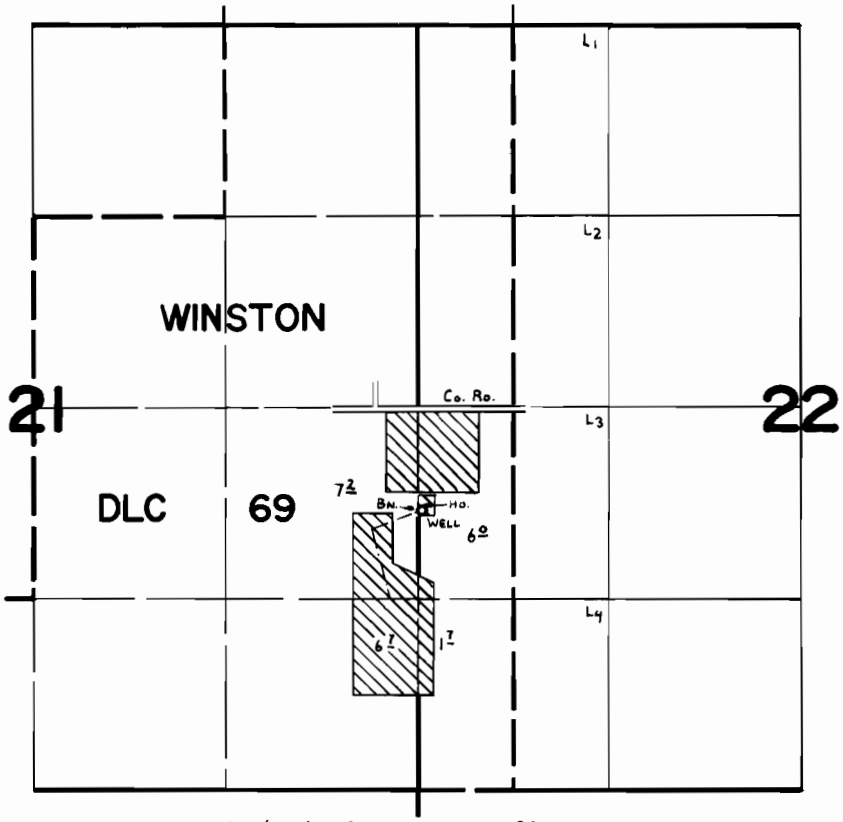

WELL LOC: 1920' N. & 30' E. fr. S.W. COR. SEC. 22.

FINAL PROOF SURVEY
UNDER

Application No. G-7549 Permit No. G-7017
IN NAME OF

HELEN L. SETERA

Surveyed OCT. 2 1978, by C. L. HUGHES

DFK-3LL-105