


# T.4 S. R.1 E. W.M.

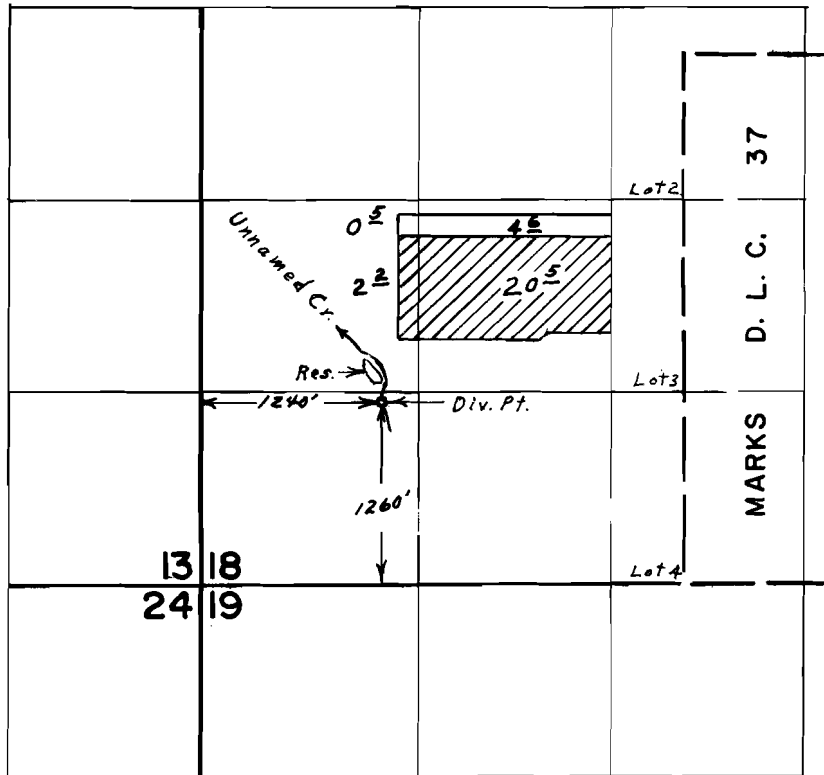

## FINAL PROOF SURVEY UNDER

Application No. 50389 Permit No. 38031  
IN NAME OF

L. R. PETERS

Surveyed MARCH 30, 1976, by L. E. Gould