


T.6N. R.2W. W.M.

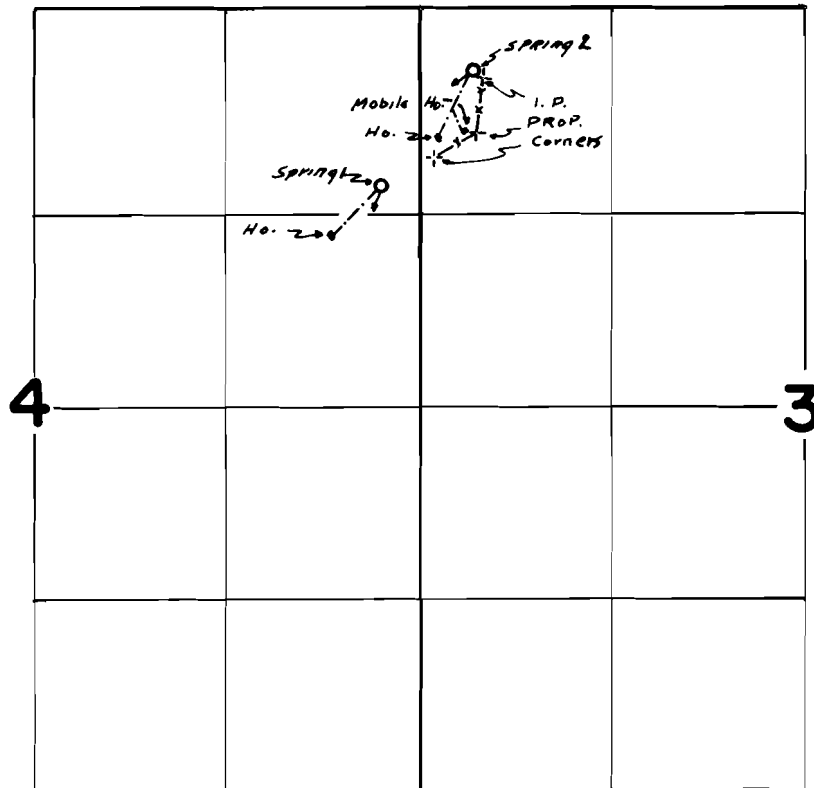

SPRING LOC'S: #1 - 1200'S; 250' W } BOTH FROM NW COR. SEC 3
#2 - 425'S; 350' E }

FINAL PROOF SURVEY
UNDER

Application No. 53568 Permit No. 40323
IN NAME OF

MRS. DALE L. MANSUR

Surveyed 8-24 1977 by S.C. BROWN