


T.29S. R.14W. W.M.

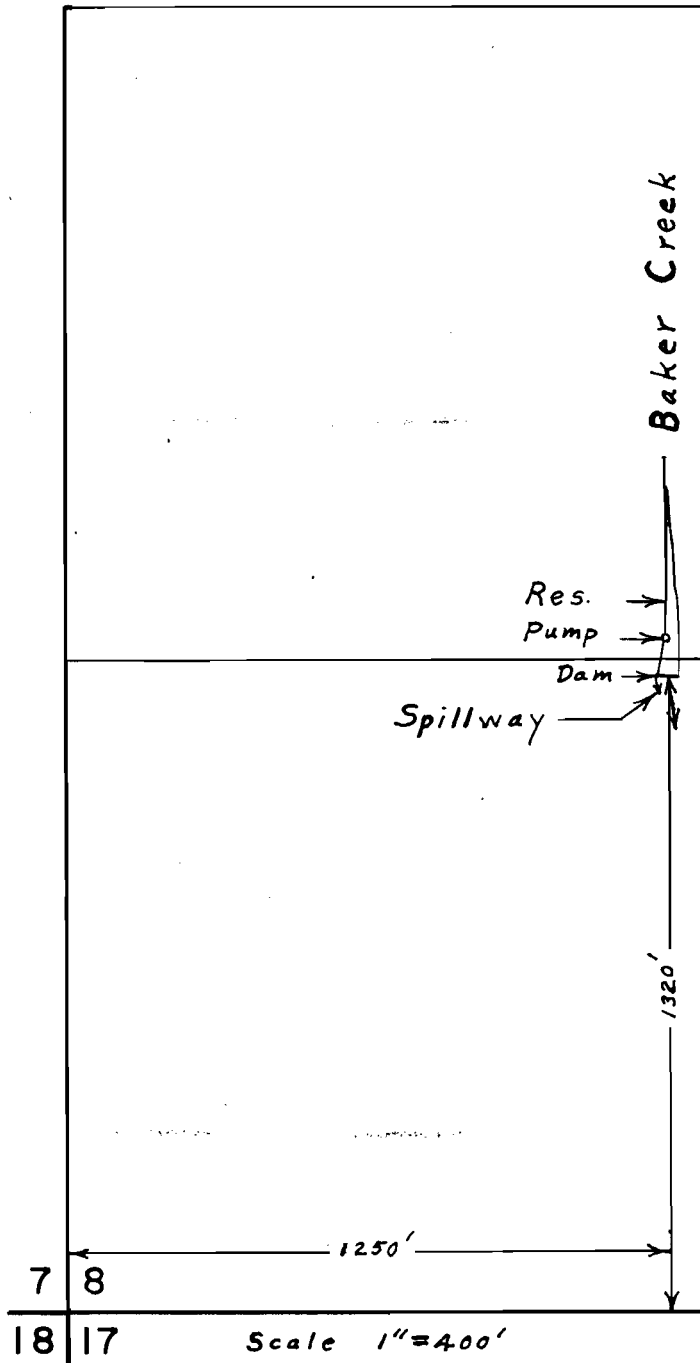

FINAL PROOF SURVEY
UNDER

R-52035 R-6281
Application No. ~~52036~~ Permit No. ~~39218~~
IN NAME OF

LORIS A. WILLETT

Surveyed July 21, 1976, by L. E. Gould.