


T.21S. R.5W. W.M.

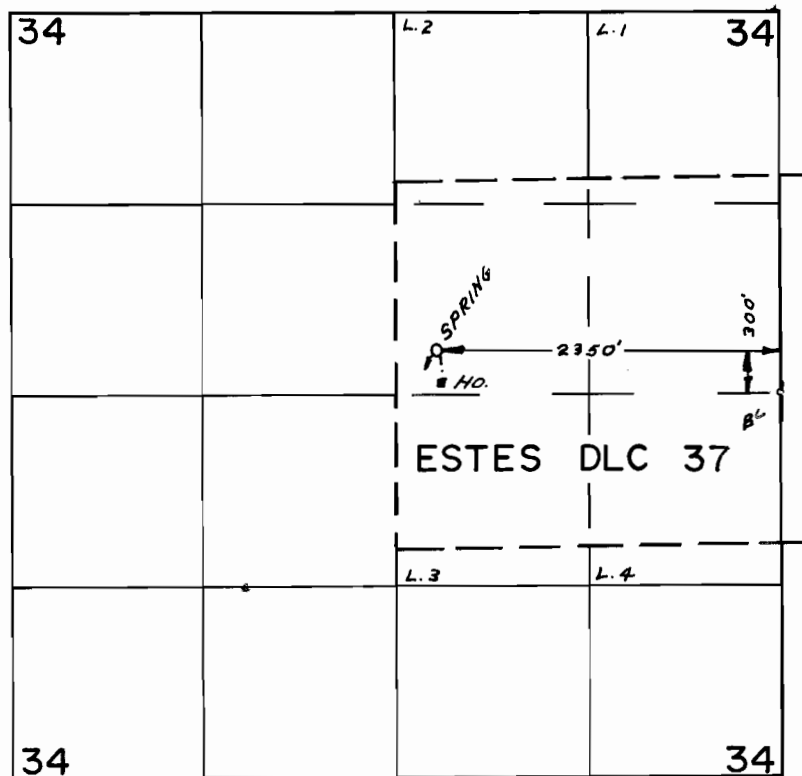

FINAL PROOF SURVEY
UNDER

Application No. 53081... Permit No. 38575...
IN NAME OF

ERWIN & LINDA HANGER.....

Surveyed APR. 21.. 1977, by L.H. NUNN.....