


T. 31 S.

R. 1 W.

Mer.

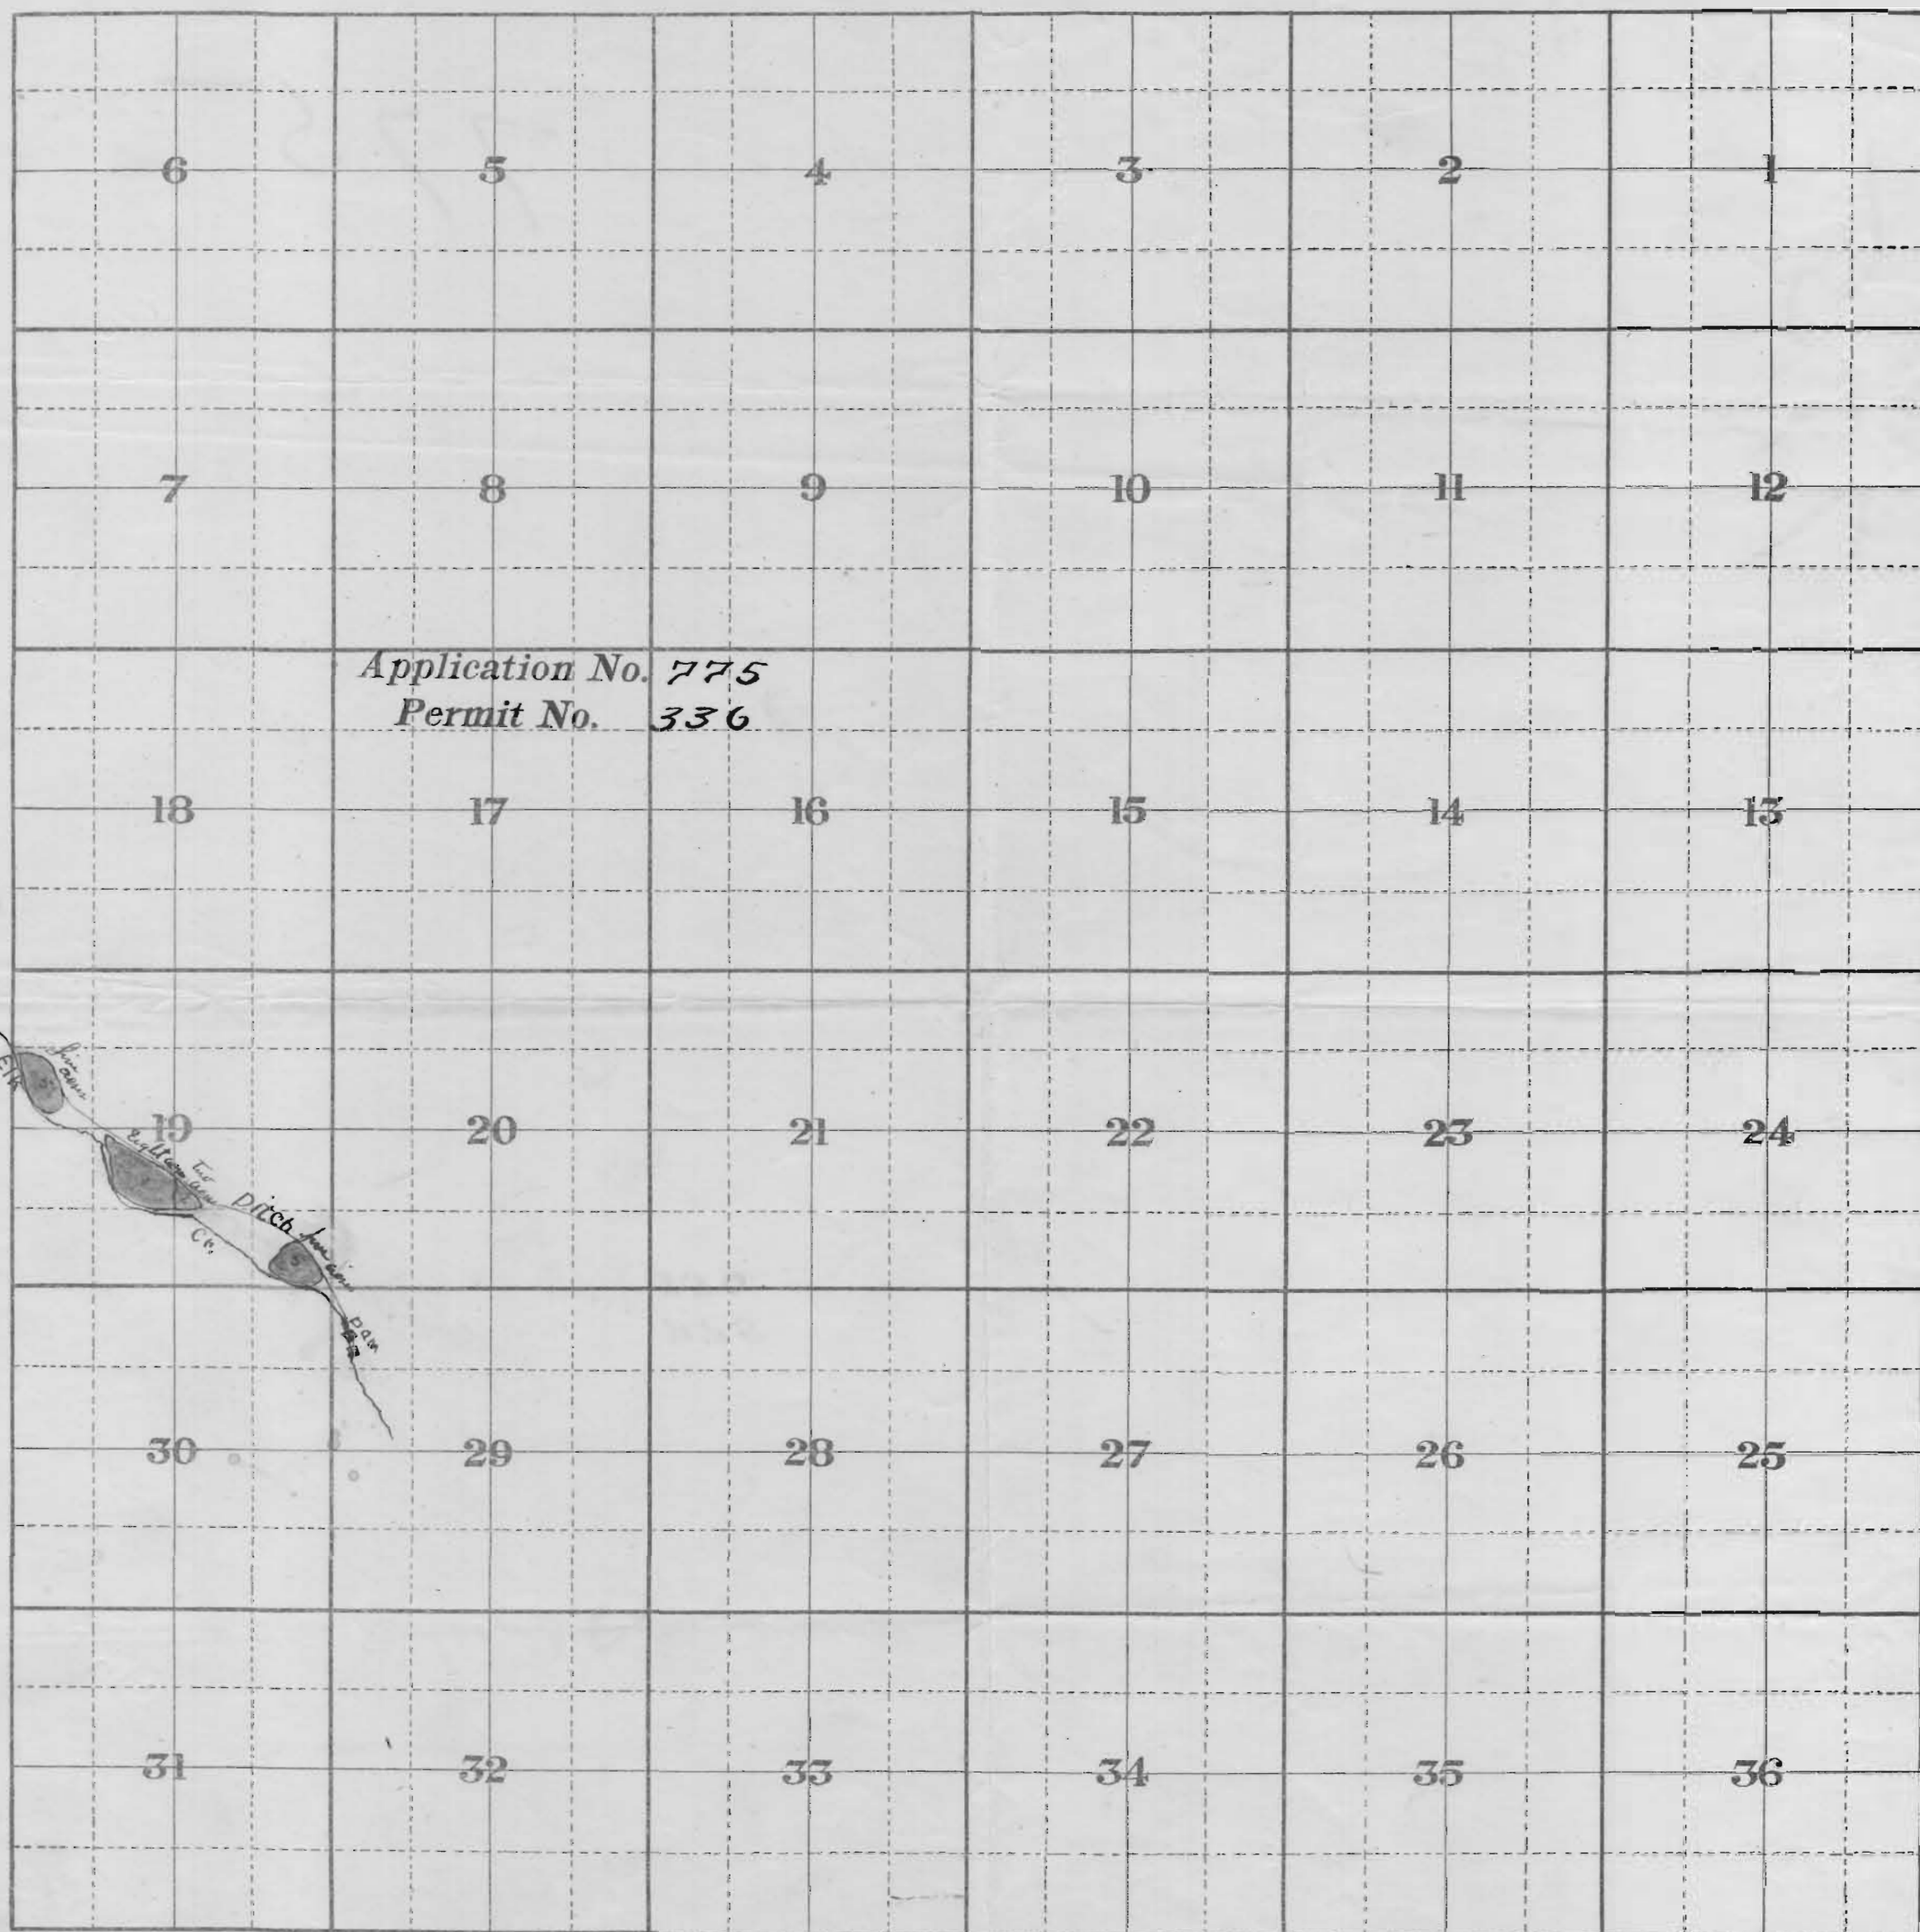

2-530

SCALE.—Two inches = 1 mile.

Andrew T. Poole
Drew Oregon