


T.13S. R.31E.W.M.

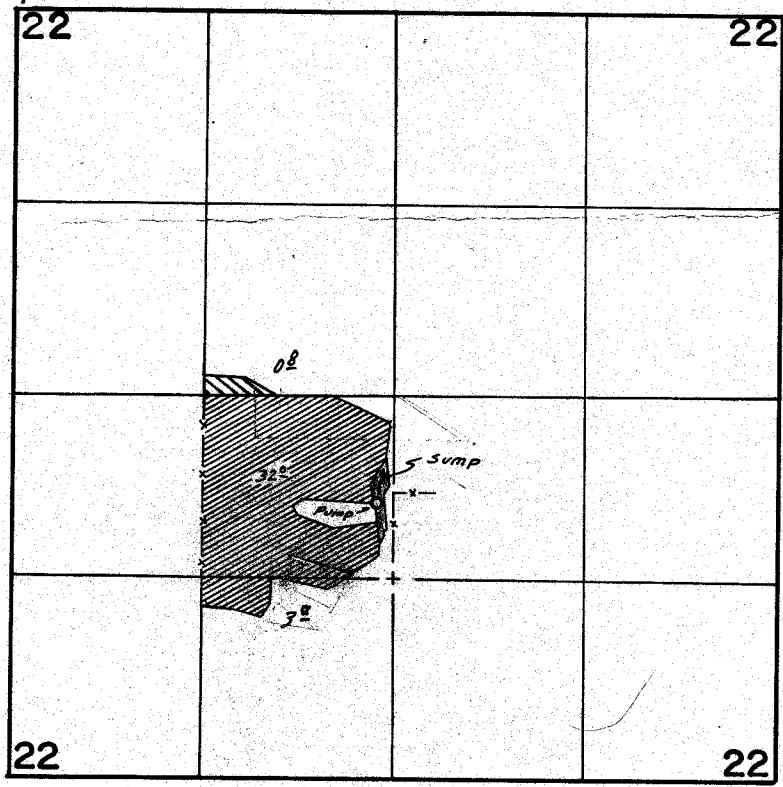

Pump Located @ 1880' N of 2520' E From SW Cor. Sec 22

-  SUPPLEMENTAL
-  PRIMARY

FINAL PROOF SURVEY UNDER

Application No. G-5257 Permit No. G-5109
IN NAME OF

GRANT DEVELOPMENT COMPANY

Surveyed Sept. 16 1977, by S.C. BROWN