


P-28930
P-28933
48003
48002

T.10S.R.29E.W.M.

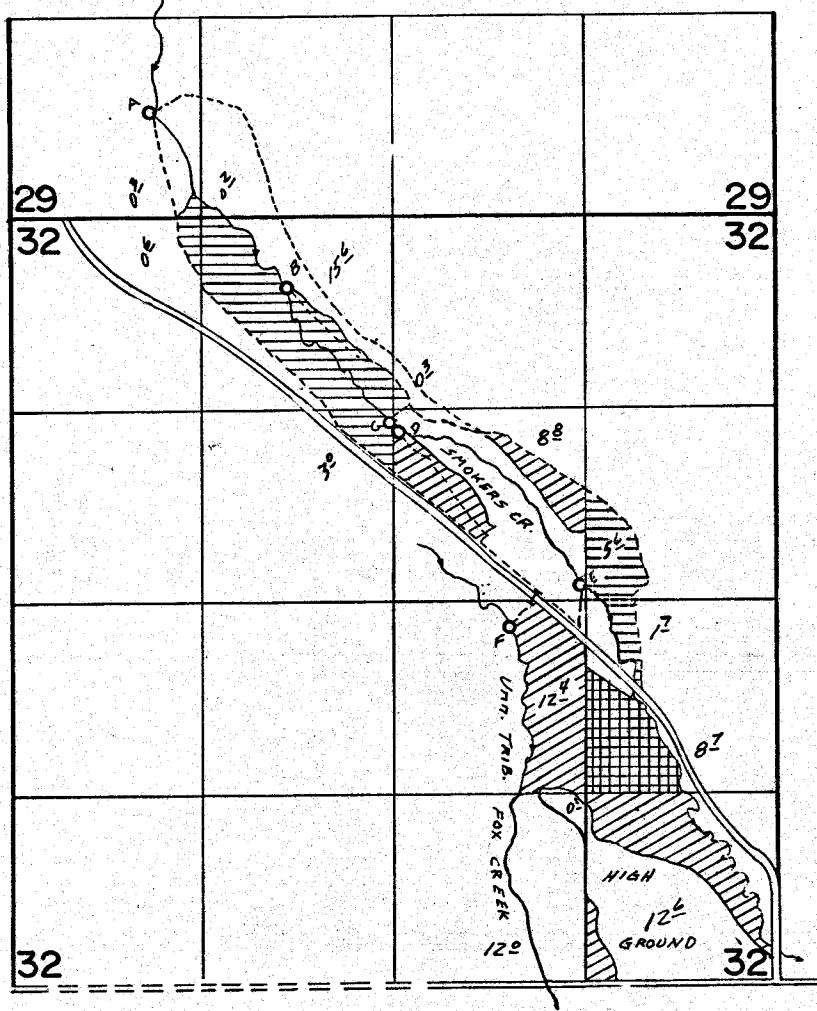

LOCATION
OF
DIVERSION
POINTS;

- (A) 720' N 950' E From SW Cor. Sec. 29
- (B) 480' S 1900' E From SW Cor. Sec. 29
- (C) 1400' S 2600' E From NW Cor. Sec. 32
- (D) 1160' N 40' E From Center Sec. 32
- (E) 2540' S 1350' W From NE Cor. Sec. 32
- (F) 180' S 800' E From Center Sec. 32

App.-38639

FINAL PROOF SURVEY UNDER

App.-38462

Smokers
Canyon Cr. &
Unn.Str.



Application No. 38642 Permit No. 28933
IN NAME OF

Smokers
Canyon Cr.
Unn.Str. &
Smokers
Canyon Cr.

JACK E. JOHNS - VAUGHAN RANCH

Surveyed Oct. 19 1977, by S.C. BROWN