


P-28930

P-28933

48003

48002

T.IOS.R29E.W.M.

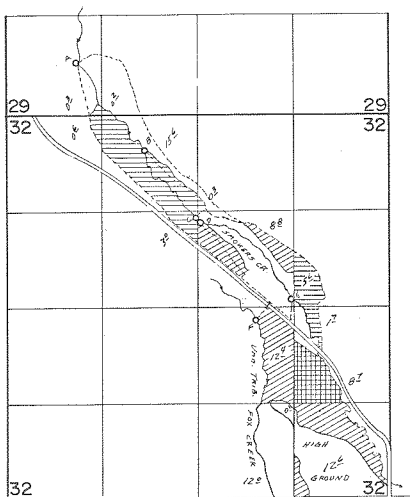

LOCATION
OF
DIVERSION
POINTS;

- (A) 720' N 1/2 S E From SW Cor. Sec. 29
 (B) 480' S 1/2 E From SW Cor. Sec. 29
 (C) 1400' S 1/2 E From NW Cor. Sec. 32
 (D) 1400' N 1/2 E From Center Sec. 32
 (E) 2540' S 1/2 W From NE Cor. Sec. 32
 (F) 180' S 1/2 E From Center Sec. 32

App.-38639

FINAL PROOF SURVEY UNDER

App.-38462

Smokers
Canyon Cr. &
Unn.Str.



Application No. 38642 Permit No. 28933
 IN NAME OF

Smokers
Canyon Cr. 
 Unn.Str. &
 Smokers
Canyon Cr. 

JACK E. JOHNS — VAUGHAN RANCH

Surveyed Oct. 19, 1977, by S.C. BROWN