


T.I.S.R.26E.W.M.

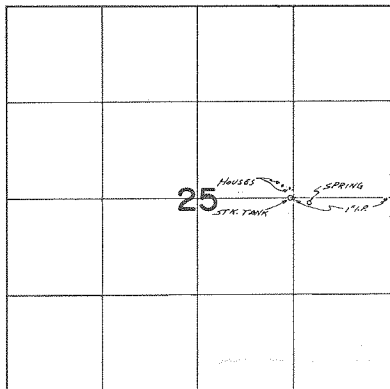

SPRING LOC. - 60' S 11' 40' W From E 1/4 Cor. Sec. 25

FINAL PROOF SURVEY

UNDER

Application No. 45511..... Permit No. 33965.
IN NAME OF

.....HOLLIS & EVELYN BEUCLER.....

Surveyed Sept. 21, 1977, by S.C.BROWN.....