


P-34346

48005

T.9S.R.26E.W.M.

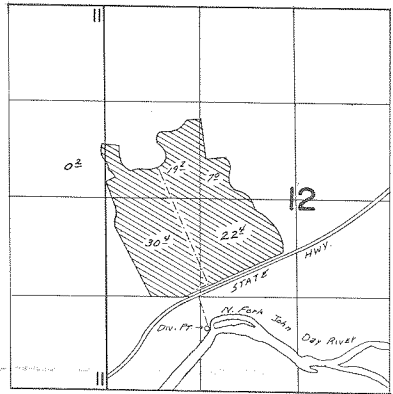

Div. Pt. Loc. - 860' N of 1220' W From S 1/4 Cor. Sec. 12

FINAL PROOF SURVEY UNDER

Application No. 45979... Permit No. 34346..
IN NAME OF

.....GORDON & HELEN McDONALD.....

Surveyed Oct. 12, 1977, by S.C. BROWN.....

DDU-177-54 228