

MAP B



SCALE 1" = 200'

21-IN-10 HOOD RIVER CO. ORE.

APPLICATION NO. 50739 &

R-61641

R 6184

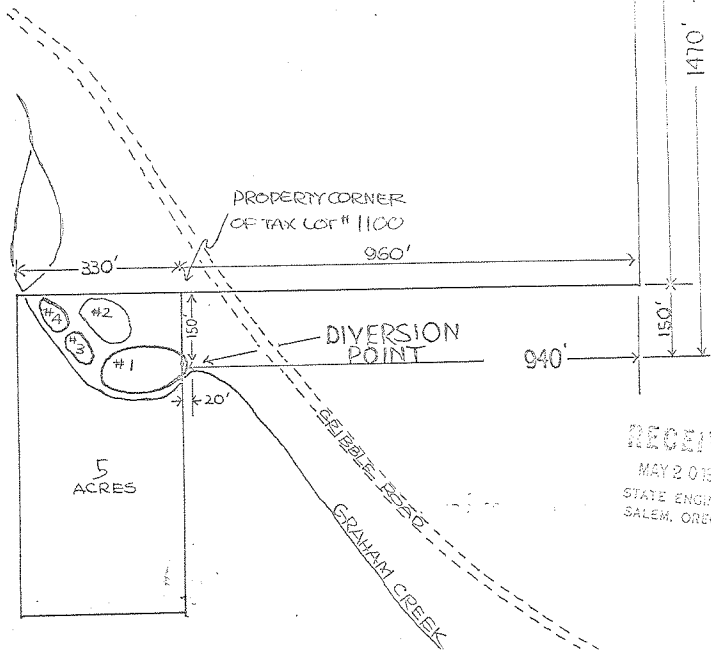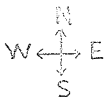

RECEIVED
MAY 20 1974
STATE ENGINEER
SALEM, OREGON