

# MAP B



SCALE 1" = 200'

## 21-1N-10 HOOD RIVER CO. ORE.

APPLICATION NO. 50739 &

R-51641

R 6184

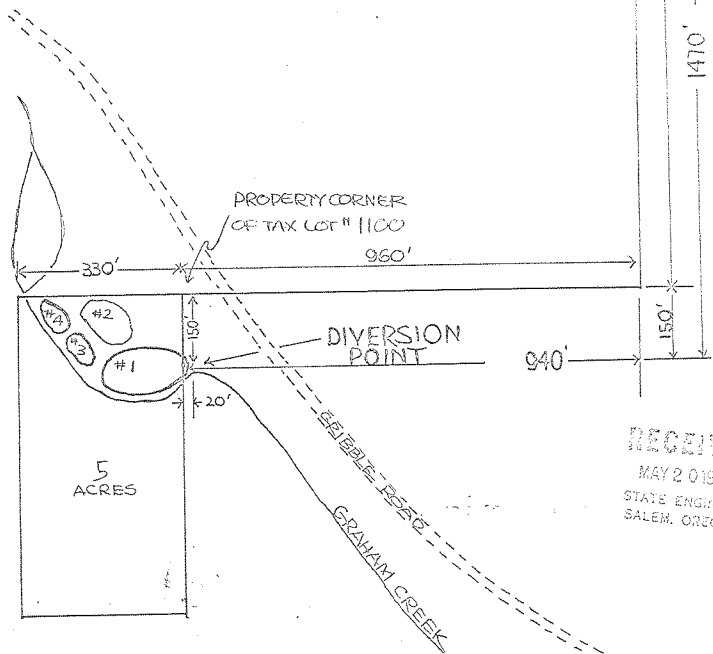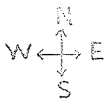

RECEIVE

MAY 2 0 1974

STATE ENGINEER  
SALEM, OREGON