


T. 38 S., R. 4 W., W.M.

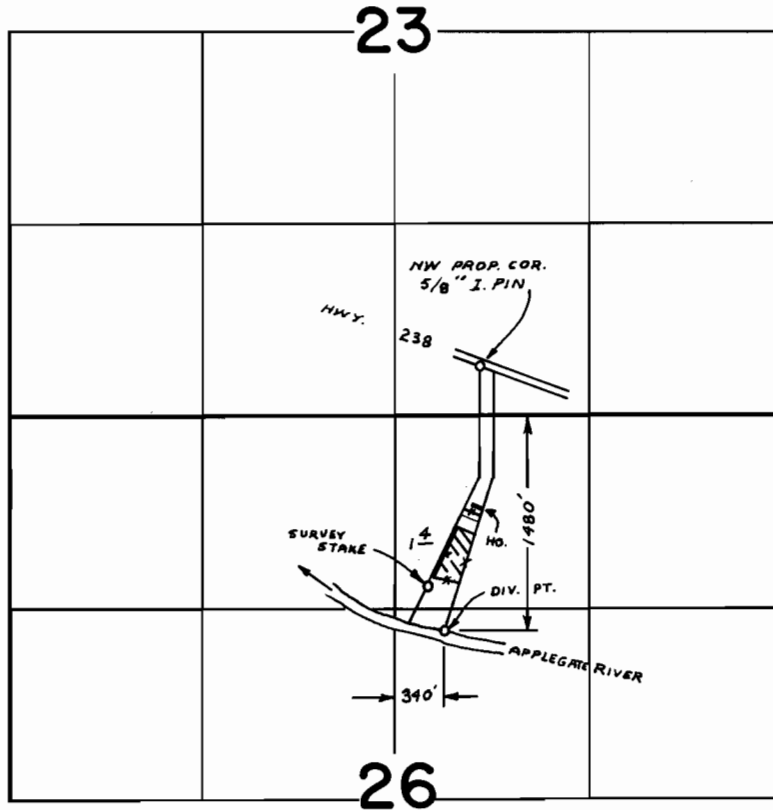

**FINAL PROOF SURVEY**  
UNDER

Transfer No. 3377

Application No. 54050 Permit No. 40424  
IN NAME OF

JOY C. NEWMAN

Surveyed JUN. 20 1978 by B. SUND