


T. 40S. R. 4W. W.M.

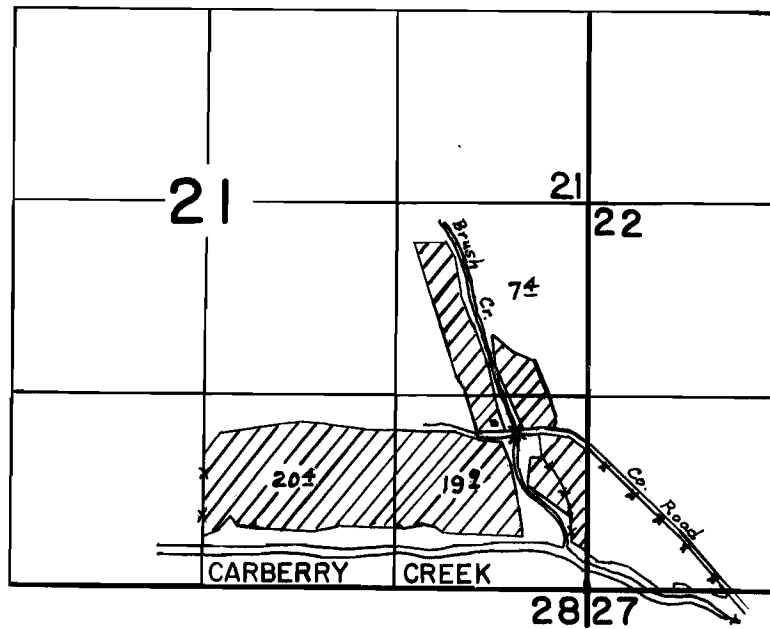


DIVERSION POINT FROM STURGIS CREEK, BEING 10'S &
280'W FROM E. 1/4 COR. SEC. 19 T. 40S. R. 4W. W.M.

FINAL PROOF SURVEY
UNDER


Application No. 31300..... Permit No. 24651 ...
IN NAME OF

TRUMAN AUBREY

Surveyed 24 MAR. 1970, by D.C. HENDRIX.....

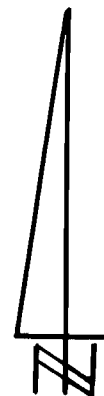

T.40S. R.4W.W.M.

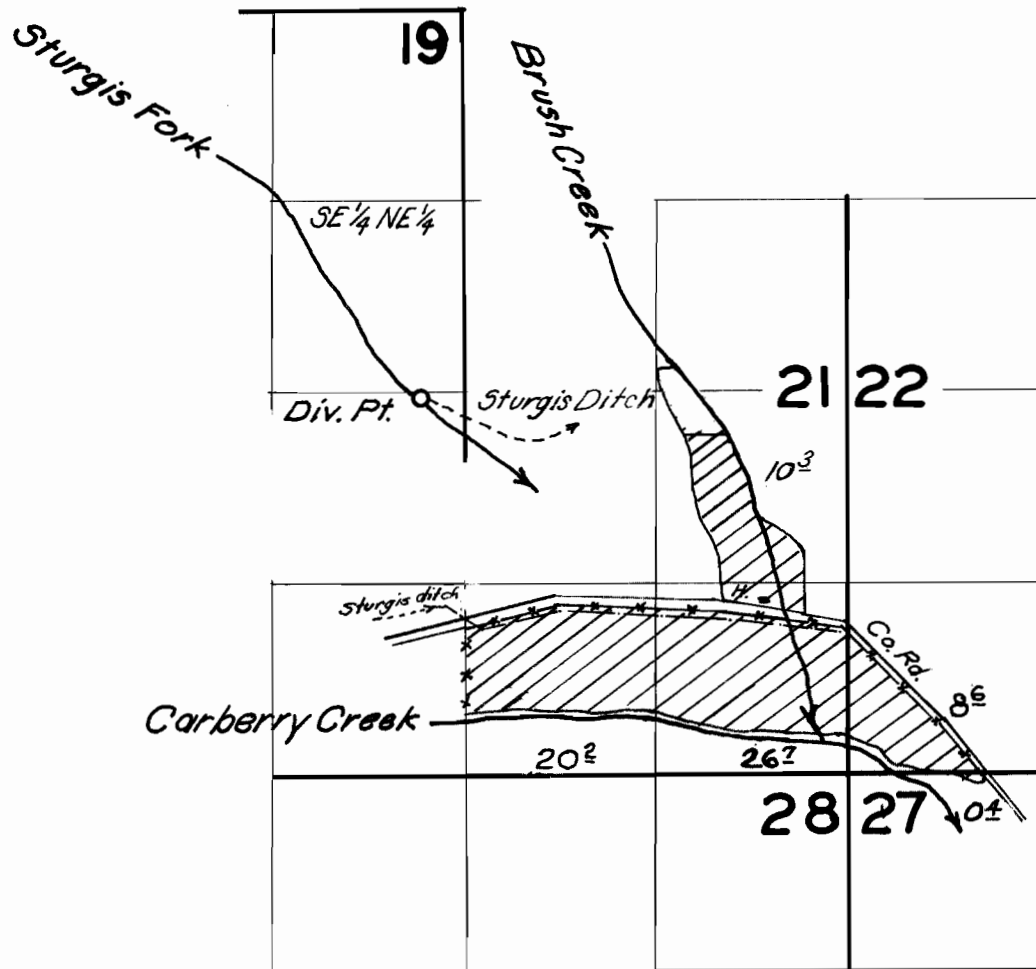

FINAL PROOF SURVEY
UNDER

Application No. 31300 Permit No. 24651
IN NAME OF

Truman Aubrey

Surveyed 18 April 1962, by Carl R. Baker