


# T. 9S., R. 14E., W.M.

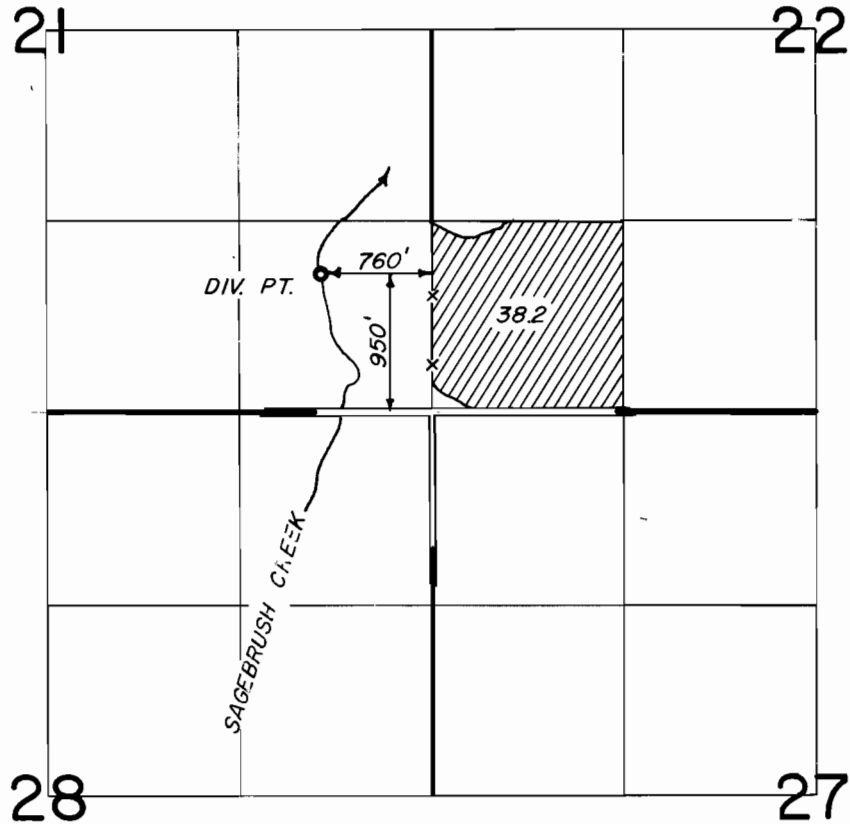

## FINAL PROOF SURVEY UNDER

Application No. 53273 Permit No. 39926  
IN NAME OF

E. O. Borthwick

Surveyed June 14, 1978, by L. H. NUNN

DOV-3BB-73 *dlB*