


T. 38 S., R. 8 W., W.M.

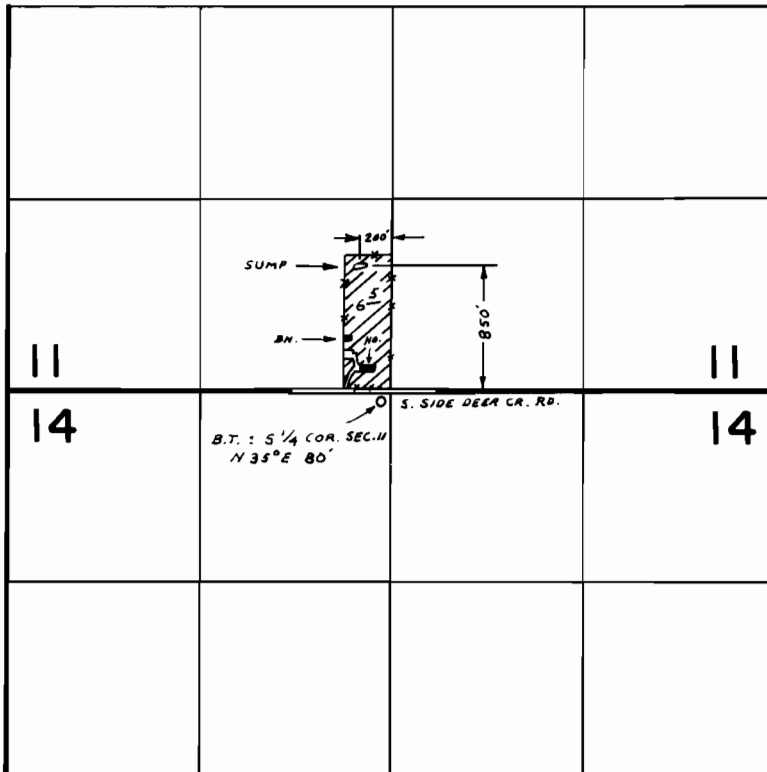

FINAL PROOF SURVEY UNDER

Application No. G-7504 Permit No. G-6984
IN NAME OF

DON L. METCALF

Surveyed JUL. 19 1978, by B. SUND