


T.40S. R.IIE., W.M.

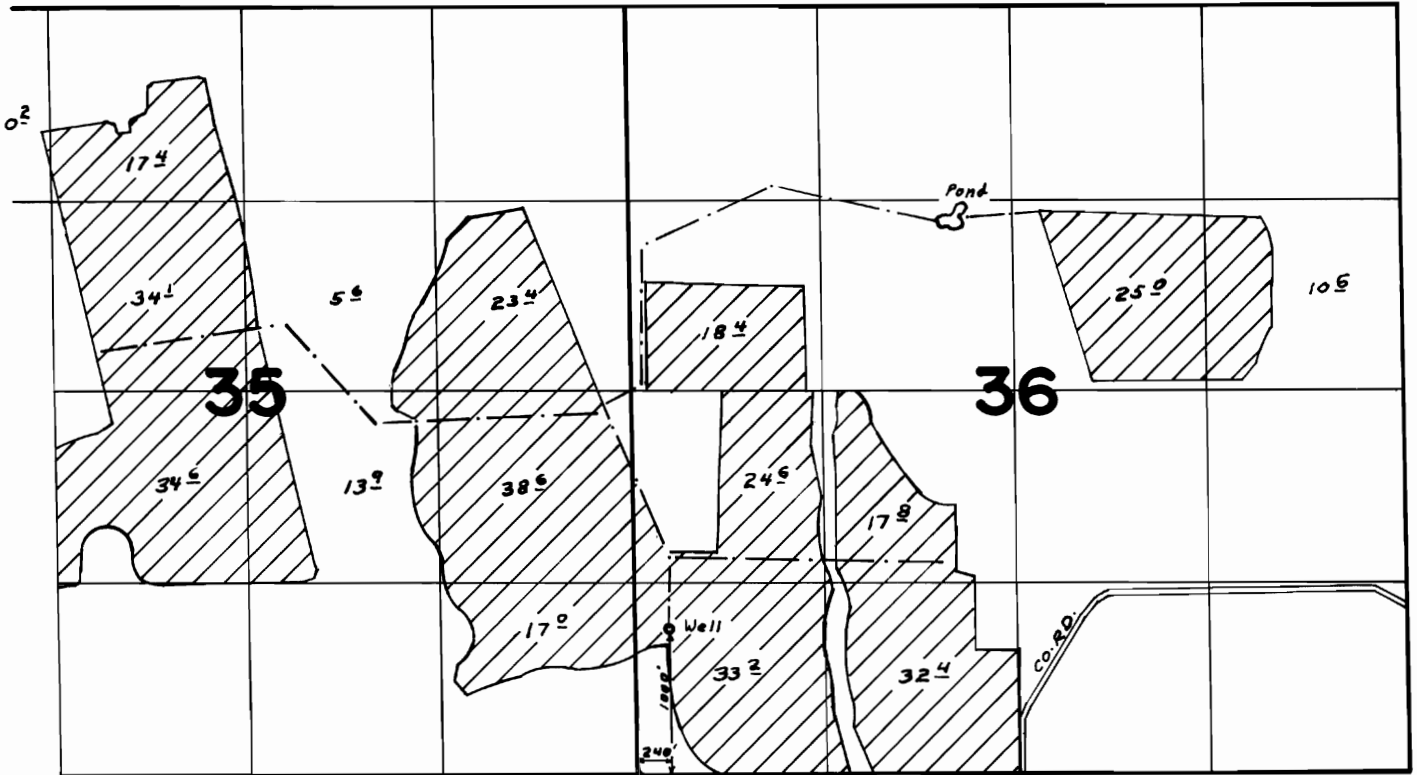

FINAL PROOF SURVEY UNDER

Application No. G-5377. Permit No. G-5310.
IN NAME OF

RAJNUS BROTHERS

Surveyed AUG. 1, 1978, by S.P. APPLIGATE.