


T.38S. R.10E. W.M.

G-4968  
48023

Swan Lake & Mac. Wells

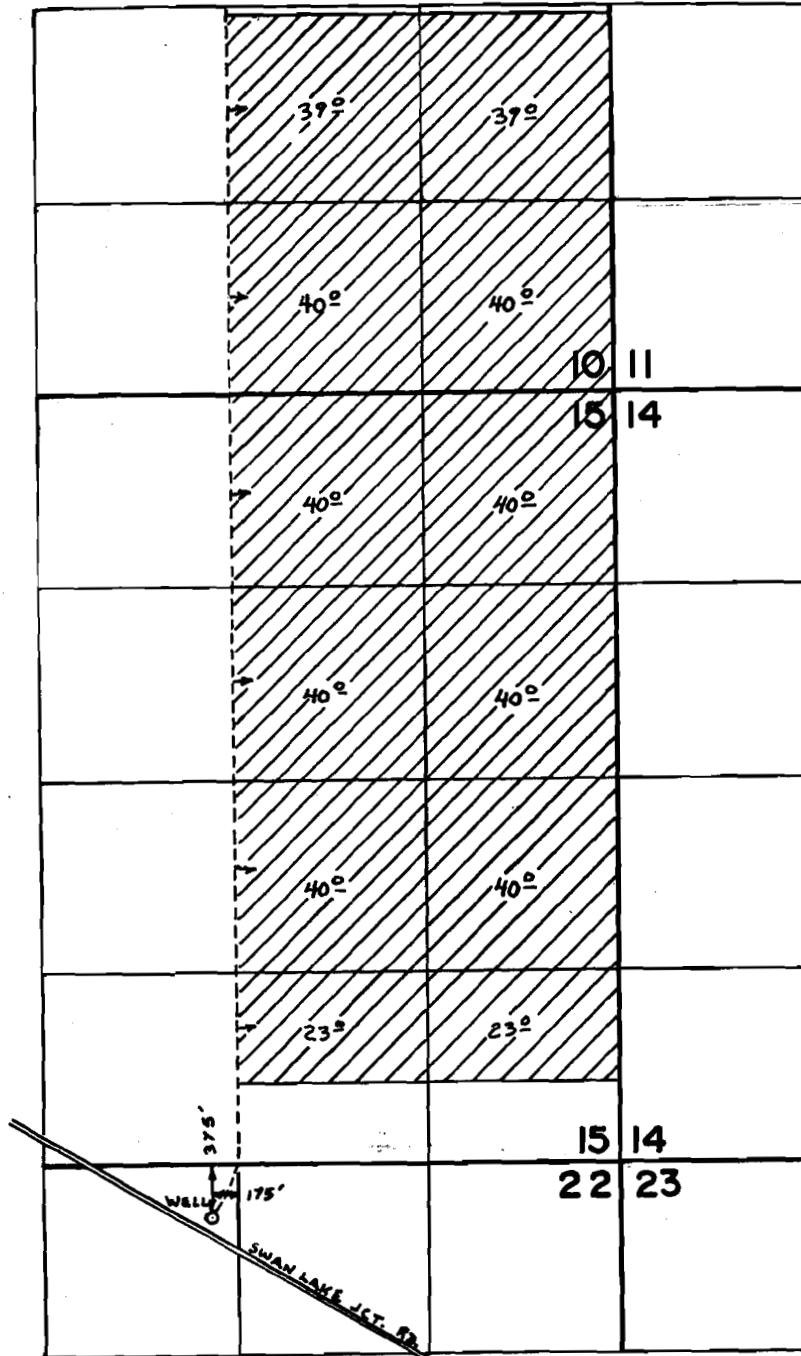

**FINAL PROOF SURVEY**  
UNDER

Application No. G-5504 Permit No. G-4968  
IN NAME OF

MIKE and BESSIE SHORT

Surveyed AUG. 23, 1977., by D. NORBY