


G-5641

48024

# T.39S. R.10E. W.M.

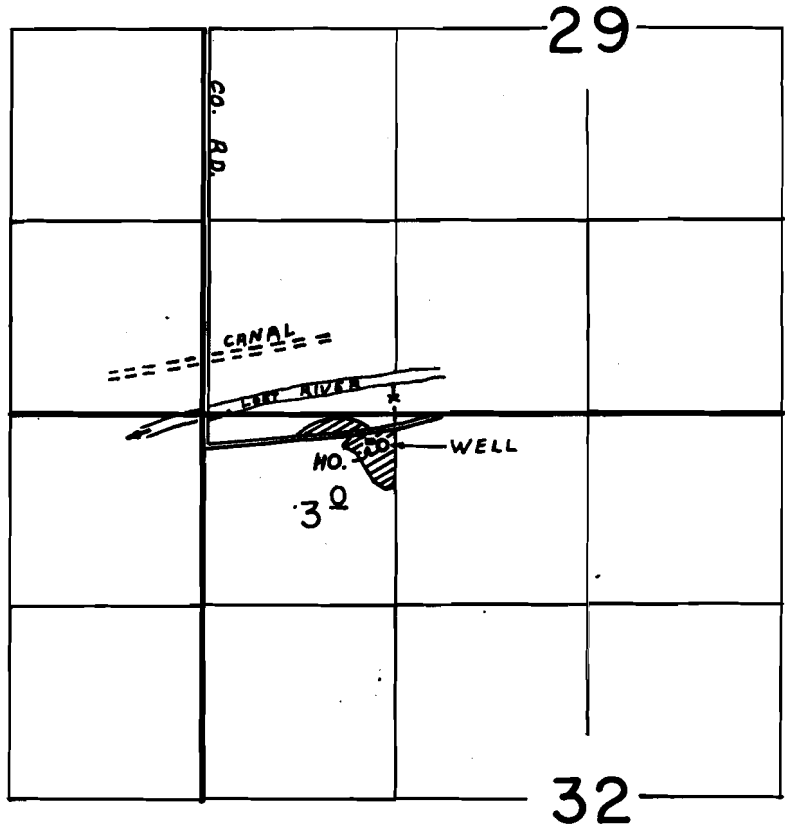


WELL LOC. 310' S. + 1220' E. FROM N.W. COR. SEC. 32

## FINAL PROOF SURVEY UNDER

Application No. G-5939... Permit No. G-5641...  
IN NAME OF

.....PENNY I. HUCK.....

Surveyed OCT. 17., 1977., by R.G. MUCKEN.....