
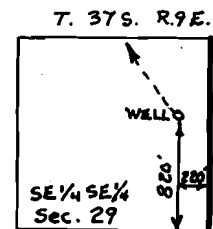


G-5188
48025

T.37S. R.9E. W.M.

Open Kamath Lake wells

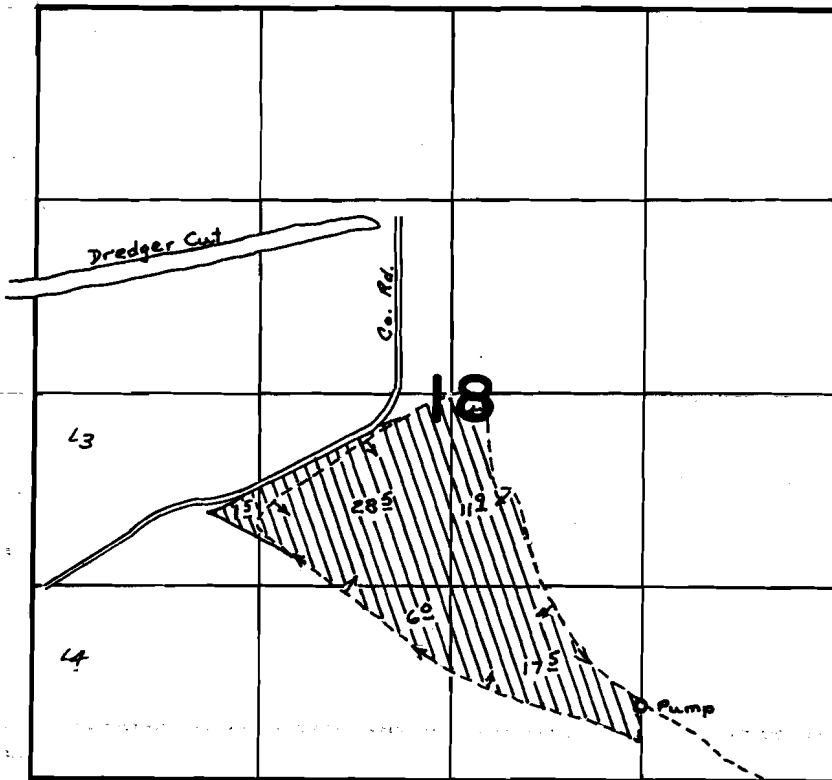

FINAL PROOF SURVEY UNDER

Application No. G-6349 Permit No. G-5188
IN NAME OF

LEWIS & NONA B. HAGELSTEIN

Surveyed AUG. 24, 1977, by D. NORBY