

OFFICE OF STATE ENGINEER
 RECEIVED
 JUN 24 1921
 SALEM, OREGON


Map of

School District No. 27. Water Right

CERTIFICATE OF SURVEYOR

I A.M. Austin of Tillamook Oregon do hereby certify that this map was made from notes taken during an actual survey made by me (or under my immediate supervision) on May 3rd 1921 and that it correctly represents the works described in the accompanying application, together with the location of streams and other ditches in the vicinity, and has written thereon the area in each smallest legal subdivision which it is proposed to irrigate.

A.M. Austin
 Surveyor

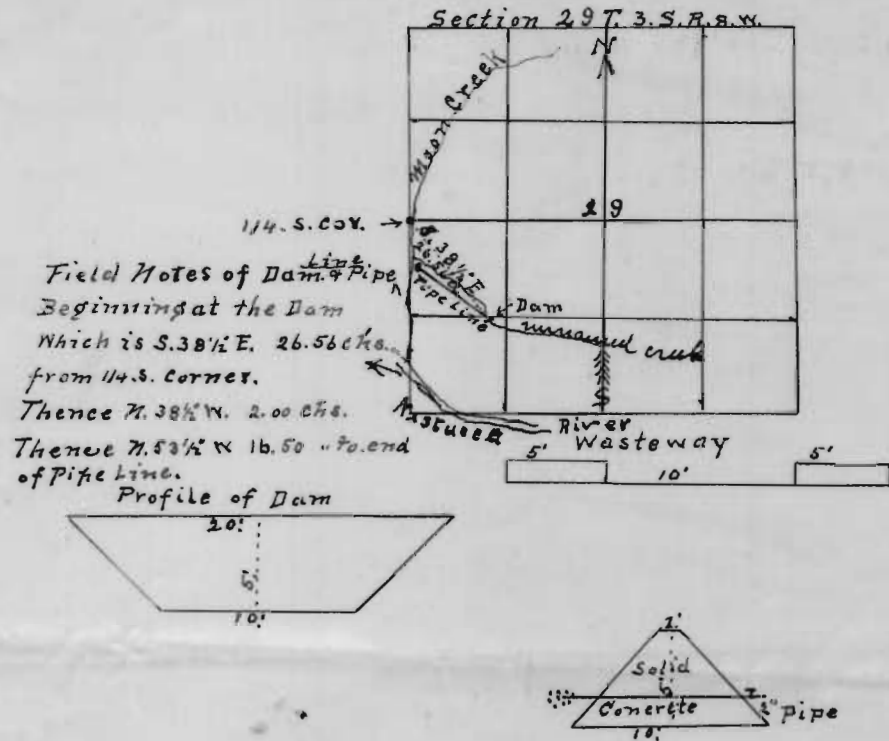

Application No. 7944
 Permit No. 5108